


USDA-FOREST SERVICE

Index File No. D-13 **CORNER RECORD (SEARCH)** (Ref. FSM 7151.4) Tract or Survey No. _____ Cor. No. S-1/16
 T 5S R. 33½E R.D. Ukiah County Umatilla
 Merid. Willamette N.F. Umatilla State Oregon

CORNER DIAGRAM

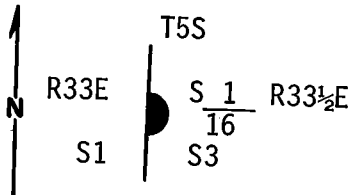

DESCRIBE CORNER MONUMENT FOUND

No corner was originally set.

DESCRIBE BEARING TREES OR OTHER OFFICIAL ACCESSORIES FOUND

None set.

PHOTO IDENTIFICATION DATA

Photo No. _____
 Filed At. _____
 Object Ident. _____
 Ident. By _____

Signature _____

PLANE COORDINATE POSITION DATA

State _____ Zone _____
 X _____
 Y _____
 Estab. By _____

Agency _____

Signature _____

DESCRIBE CORNER LOCATION RELATIVE TO NEAR-BY FEATURES, ALSO HOW TO REACH CORNER

Corner falls 18' South of E-W fence. Take USFS Road 5160-2-- West to S.E. corner of S1, T5S, R33E and walk south 350' to corner.

Title _____

Division ORLS

Headquarters 1294

Date 9/77

7100-52-(3/68)

CORNER RECORD (PERPETUATION)

MONUMENT: DESCRIBE NEW MONUMENT SET, OR WORK DONE TO PRESERVE EXISTING MONUMENT

T5S

At surveyed point set 2½"x30" galvanized pipe with brass cap stamped:
Set pipe 24" in ground with mound of stone to cap.

R33E | S $\frac{1}{16}$ R33½E
S1 | S3

9

ACCESSORIES : DESCRIBE NEW BT'S WITNESS OBJECTS ETC. ESTABLISHED, OR WORK DONE TO PRESERVE EXISTING EVIDENCE

Bearing Trees: A Douglas Fir 7" dia. bears S37°E, 61.5 ft., scribed S1/16 S3 BT.
A Douglas Fir 16" dia. bears N50°E, 34.2 ft., scribed S1/16 S3 BT.
Attached 54-3 and 54-4 signs to both BTs. Attached brass washer stamped LS 1294 to foot blaze of both BTs. Painted blazes and 6" band around both BTs. red. Attached 54-2 and 54-4 signs to metal post 5' south of corner. Attached 54-2 and 54-9 signs to metal post 5' east of corner.

10

Work Done By R.C. Orton Title Party Chief Date 7/8/80 State Registration No. _____
or Agency _____

Certified Cor. Record Prepared ? Yes No Filed At: _____ Date _____

11

REMARKS

Witnesses: R. Orton
D. Allen
L. Huntsman

12

Index File No. D-13 T. 55 R. 33½E M. _____ Tract or Surv. No. _____ Cor. 13
U.S. G.P.O. 1977-725-576/586