

USDA-FOREST SERVICE

Index
File No. G-19

CORNER RECORD (SEARCH)
(Ref. FSM 7151.4)

Tract or
Survey No. _____ No. G-19


T 5S R. 33½E

R.D. Ukiah County Umatilla

Merid. Willamette

N.F. Umatilla State Oregon

CORNER DIAGRAM

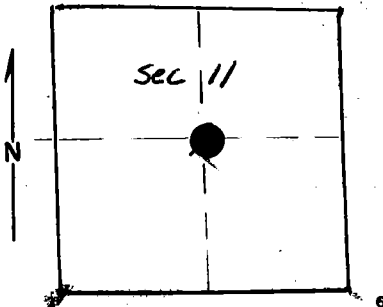

DESCRIBE CORNER MONUMENT FOUND

None

DESCRIBE BEARING TREES OR OTHER OFFICIAL ACCESSORIES FOUND

None

PHOTO IDENTIFICATION DATA

Photo No. _____

Filed At. _____

Object Ident. _____

Ident. By _____

Signature

PLANE COORDINATE POSITION DATA

State _____ Zone _____

X _____

Y _____

Estab. By _____

Agency

DESCRIBE CORNER LOCATION RELATIVE TO NEAR-BY FEATURES, ALSO HOW TO REACH CORNER

From intersection of roads S552 and S534, which is about 700 feet West of Frazier Guard Station, go South on Road S534 about 1.3 miles. The corner is South of the road about 2 chains in density trees.

Signature

Terry C. Hamby

Title

Division

O.P.L.S.

Headquarters

1638

Date

8-78

7100-52-(3/68)

5

CORNER RECORD (PERPETUATION)

MONUMENT: DESCRIBE NEW MONUMENT SET, OR WORK DONE TO PRESERVE EXISTING MONUMENT

Set 2½" x 30" iron pipe with brass cap (stamped).
Pipe is 24" in ground.

T 5S R 33½E

C¼ S 11

1978

PLS 933

9

ACCESSORIES : DESCRIBE NEW BT'S WITNESS OBJECTS ETC. ESTABLISHED, OR WORK DONE TO PRESERVE EXISTING EVIDENCE

Tamarack 22" diameter bears South 17° 12' West 27.20 feet with signs 54-3 and 54-4.
Fir 9" diameter bears South 84° 25' West 17.50 feet with signs 54-3 and 54-4.

Set steel post 3 feet East.
Painted red band.

10

Work Done By T. Hamby Title Surveyor Date 7/19/78 State Registration No. O.P.L.S. 1638
or Agency

Certified Cor. Record Prepared ? Yes No Filed At: Umatilla County Surveyor Date 8-8-78

11

REMARKS

Witness by Richard Barton and William Hampton

12

Index File No. T. R. M. Tract or Surv. No. Cor.

13