


History of original corner establishment:

Corner established in 1882 by Rufus S. Moore under Contract No. 451.

80.00 chains set stone 20" x 18" x 12" side hill for corner to Sections 11, 12, 13, and 14.

- A pine 36" diameter bears North 39° East 71 lks. dist.
- A pine 12" diameter bears North 50° East 45 lks. dist.
- A pine 36" diameter bears South 68° East 85 lks. dist.
- A fir 30" diameter bears South 6° West 85 lks. dist.

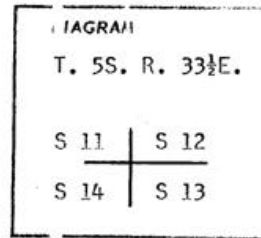

No record of subsequent remonumentation found in County Records.

Description of corner evidence found:

None.


Description of monument and accessories established to perpetuate the original location of this corner

Set 2 1/2" x 30" iron pipe 20" in ground with brass cap marked as shown: from which I scribed new Bearing Trees.

- A fir 12" diameter bears North 17°42' West 29.20 feet marked T 5S R 33 1/2 E S 11 BT
- A tamarack 18" diameter bears North 38°50' East 9.50 feet marked T 5S R 33 1/2 E S 13 BT
- A tamarack 12" diameter bears South 57°32' East 3.00 feet marked T 5S R 33 1/2 E S 13 BT
- A fir 24" diameter bears South 32° West 9.00 feet marked T 5S R 33 1/2 E S 14 BT

I nailed a brass washer marked PLS 933 to the BT blaze of all the trees. Set steel fence post 5 feet East of corner. The corner is East 50 feet of a road which runs North-South. Used T-2 and steel tape, measuring a horizontal distance to the center of the Bearing Trees.

REGISTERED
 PROFESSIONAL
 AND SURVEYOR
David H. Krumbein
 OREGON
 JULY 17, 1950
 DAVID H. KRUMBEIN
 933

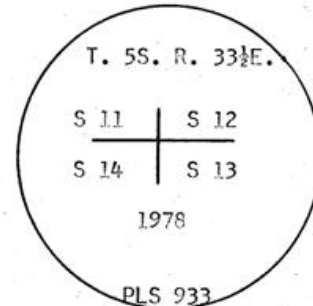

Office of County Surveyor County of Umatilla
 State of Oregon , I hereby certify that the within instrument was filed in this office
 for record on the day of
 by
 (COUNTY OFFICIAL) (DEPUTY)

J-21