


CERTIFIED RECORD OF LAND CORNER MONUMENTATION

E-13

History of original corner establishments:

The corner established by General Land Office contract survey  
 The original notes state;  
 North between sections 9 and 10.  
 80.00 Set a basalt stone 16 x 9 x 6", 11" in ground  
 for corner to sections 3, 4, 9, and 10 from which a;  
 Pine 36" dia bears S12°W, 190 lks dist. marked T5S R34E  
 S9 BT  
 Pine 5" dia bears S32°E, 56 lks dist. marked T5S R34E S10 BT  
 Fir 18" dia bears N53°E, 131 lks dist. marked T5S R34E S3 BT  
 Pine 20" dia bears N38°W, 153 lks dist. marked T5S R34E S4 BT

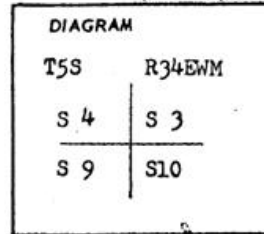


Description of corner evidence found:

In section 4, found 42" stump.  
 In section 3, found 42" stump.  
 In section 9, found 48" stump.  
 At the corner, found rock, all "BT" scribes.

Description of monument and accessories established to perpetuate the original location of this corner

At the position of the corner, I set a 30" galvanized pipe with an eight inch plate welded to bottom and a bronze cap on top. The hole was back filled with stone and tamped soil.

I stamped the disk.

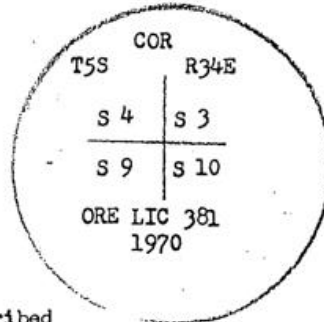

From the monument the original bearing trees were; (none).  
 I established the following new bearing trees;  
 Ponderosa Pine 12" dia, N42°W at a distance of 12.6 ft. and scribed T5S R34E S4 BT  
 Ponderosa Pine 14" dia, N8°E at a distance of 26.4 ft. and scribed T5S R34E S3 BT  
 Pine 8" dia, S14°W, at a distance of 38.1 ft. and scribed T5S R34E S9 BT  
 Ponderosa Pine 9" dia, S38°E at a distance of 7.7 ft. and scribed T5S R34E S10 BT.  
 The distance measured to center of respective trees on level. I placed bearing tree signs on both old and new bearing trees and painted stripe around trees. I placed a steel fence post with USFS sign 54-4 attached near the corner. I placed the stone along side monument.

Office of.....County..Surveyor..... County of..... Union.....  
 State of..... Oregon....., I hereby certify that the within instrument was filed in this office  
 for record on the ..18.. day of ..August....., 1970., at ..11 o'clock A.M., (signed)  
 County Surveyor..... by *J. Amis*  
 (COUNTY OFFICIAL) (SECRET)

93-39-B