

Index  
File No. G-10

CORNER RECORD (SEARCH)


(Ref. FSM 7151.4)

T 5 S R. 34 E  
Merid. Willamette

R.D. LaGrande  
N.F. WW-16

Tract or Survey No. \_\_\_\_\_  
County Union  
State Oregon  
Cor. No. W-C-1/16

CORNER DIAGRAM

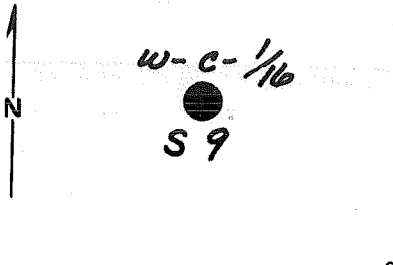

DESCRIBE CORNER MONUMENT FOUND

None

DESCRIBE BEARING TREES OR OTHER OFFICIAL ACCESSORIES FOUND

None

PHOTO IDENTIFICATION DATA

Photo No. \_\_\_\_\_  
Filed At. \_\_\_\_\_  
Object Ident. \_\_\_\_\_  
Ident. By \_\_\_\_\_  
*Signature*

DESCRIBE CORNER LOCATION RELATIVE TO NEAR-BY FEATURES, ALSO HOW TO REACH CORNER

Approx. 400 ft. S of road S536.

PLANE COORDINATE POSITION DATA

State \_\_\_\_\_ Zone \_\_\_\_\_  
X \_\_\_\_\_  
Y \_\_\_\_\_  
Estab. By \_\_\_\_\_  
*Agency*

Signature  
**Hambleton**

**ROGER GREEN 9-17-91**

Title \_\_\_\_\_  
Division **ORLS**  
Headquarters **645**

Date  
**8-78**

**CORNER RECORD (PERPETUATION)**

**MONUMENT: DESCRIBE NEW MONUMENT SET, OR WORK DONE TO PRESERVE EXISTING MONUMENT**

Set a 2 $\frac{1}{2}$ " x 30" iron pipe w/brass cap mkd.:  
Large mound of stone around monument.

T 5 S  
W-C-1/16  
S 9  
R 34 E  
1978  
ORLS 645

9

**ACCESSORIES : DESCRIBE NEW BT'S WITNESS OBJECTS ETC. ESTABLISHED, OR WORK DONE TO PRESERVE EXISTING EVIDENCE**

9" <sup>L.P.</sup> pine bears N 07 W, 26.56 ft. scribed 1/16 S S 9 BT. <sup>N 5 $\frac{1}{2}$  W</sup>  
7" <sup>L.P.</sup> pine bears N 80 E, 22.17 ft. scribed 1/16 S S 9 BT. <sup>STAMP</sup>  
Painted blase and band of BT's red & yellow. Tagged trees w/54-3&4 signs.  
Set steel fence post by mound of stone w/signs 54-4,6&9.  
ADD: A L.PINE, 10"DIAM, S 88° E, 31.8 FT. DIST., SCRIBED "CW'16 S 9 BT", w/ BRASS  
WASHER MARKED "LS 2211" NAILED BETWEEN THE B & T, DOUBLE BLAZED.

10

Work Done By J. Hambleton Title Surveyor Date 8078 State Registration No. ORLS 645  
or Agency  
Certified Cor. Record Prepared? Yes  No Filed At: Union CS Date \_\_\_\_\_

11

**REMARKS**

Witnesses: L. Green  
L. Shirley

*Boyer Green 9-17-91*

12

Index File No. G 110 T. 55 R. 34 E M. WILL. Tract or Surv. No. \_\_\_\_\_ Cor. \_\_\_\_\_

13