



History of original corner establishment:

Corner reset by BLM in 1983

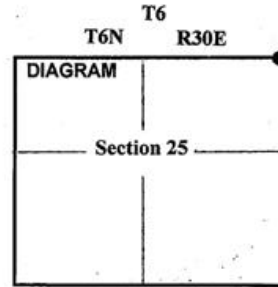

Description of corner evidence found:

Found 3" diameter aluminum cap flush with ground, 15 feet southeasterly of centerline of railroad tracts from which a 12' diameter Power pole bears: S 31° W a distance of 16½ feet.

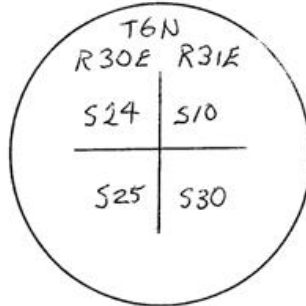

Description of monument and accessories established to perpetuate the original location of this corner:

No addition references set.



EXPIRES 12-31-99

OREGON DEPARTMENT OF TRANS.
3012 ISLAND AVE.
LA GRANDE, OR

Office of County of

State of I hereby certify that the within instrument was filed in this office for record on the

..... day of, 19.....

David H. Keen
(County Official)

by _____ (Deputy)

RECEIVED BY
 Umatilla County Surveyor
 Date 3-98
 Rec'd By JK
 No. 98-26-L