

OREGON CORNER RESTORATION FORM

Section 30 Township 6N Range 34E
 County Umatilla Date: January 8, 2003

Corner Designation: 6N34V1

Corner to sections 30 and 31, T6N, R34E, and sections 25 and 36, T6N, R33E, W.M., Umatilla County, Oregon.

State Plane Coordinates, Oregon North, 83(1991)
 N = 841892.64 E = 8679775.18



Condition Report Only
 Not found
 Remonumented
 Unrecorded
 Surveyed in
 Referenced out

Previous Renewals / Surveys, etc.

Corner originally set by Deputy Surveyors Odell & Lewis under contract No. 110 dated February 7, 1865, their record reads: Set post cor. for secs. 30, 31, 25, and 36. Drove charred stake; dug pits & raised mound as per instructions. Willard Bradley under survey Q-813-A in 1914 states: Granite rock, U.S.. Aubrey Perry under the survey in Book 2, Page 306 of the Record of Private Surveys states: U.S. rock.

Monument and Accessories found: (condition and source)

None: The position falls in a plowed field.

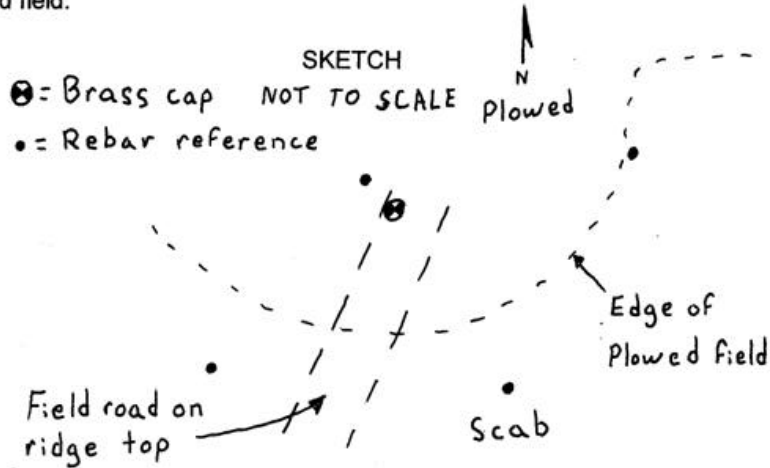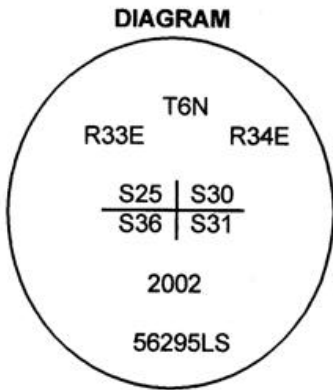

MONUMENT (S) AND ACCESSORIES SET (Procedures and Description)

I set a 2 1/4" brass cap on a 1 1/2" x 30" galvanized iron pipe 20" below the surface stamped as shown in the diagram above at the position computed from Bradley's record survey.

For references, I set four, 5/8" by 24" green coated iron rebars with 1.25" orange plastic-caps stamped WTS and 56295LS as described below:

- an iron rebar bears N68°48'36"E, 161.80 feet;
- an iron rebar bears S26°23'34"E, 84.48 feet;
- an iron rebar bears N47°36'56"W, 24.45 feet 20 inches below the surface;
- an iron rebar bears S56°36'29"W, 97.70 feet;

The monument and references were tied using a LIECA system 300 RTK GPS.

Location and comments

Compass Declination

Surveyors Seal

RECEIVED BY:
Umatilla County Surveyor
 Date: 2-03
 Rec'd By: SK
 No. 03-21-C

Firm / Agency
 Witness Tree Surveying
 Address
 P.O. Box G
 Pilot Rock, Or. 97868
 Party Chief
 Stephen K, Haddock

REGISTERED
 PROFESSIONAL
 LAND SURVEYOR

Stephen K. Haddock

OREGON
 JULY 9, 2001
 STEPHEN K. HADDOCK
 56295LS

RENEWAL DATE 6-30-03