

OREGON CORNER RESTORATION FORM

Section 30 Township 6N Range 34E
 County Umatilla Date: January 8, 2003

Corner Designation: 6N34R5

Corner to sections 19, 20, 29, and 30, T6N, R34E, W.M., Umatilla County, Oregon.



State Plane Coordinates, Oregon North, 83(1991)
 N = 847437.15 E = 8684942.25

Condition Report Only
 Not found
 Remonumented
 Unrecorded
 Surveyed in
 Referenced out

Previous Renewals / Surveys, etc.

Corner originally set by Deputy Surveyors Odell & Lewis under contract No. 110 dated February 7th, 1865. Their record reads: Set post Cor. for Secs. 19, 20, 29, & 30. Drove Charred Stake; Dug pits; raised mound, as per instructions. Willard Bradley under survey Q-813-A, 1914, states "old stake". Aubrey Perry under the survey recorded in Book 2, Page 306, 1919, of the record of private surveys states "old stake. Rock marked "x"". Dave Krumbein set a brass cap in the center of the County Rd. under survey 82-46-B. This position falls N6°E approximately 595 feet from the corner. Paul Tomkins set a brass cap under survey 01-168-C at the position of a field stone. This cap bears N7°20'13"E 440.94 feet from the corner.

Monument and Accessories found: (condition and source)
 None: The position falls in a plowed field.

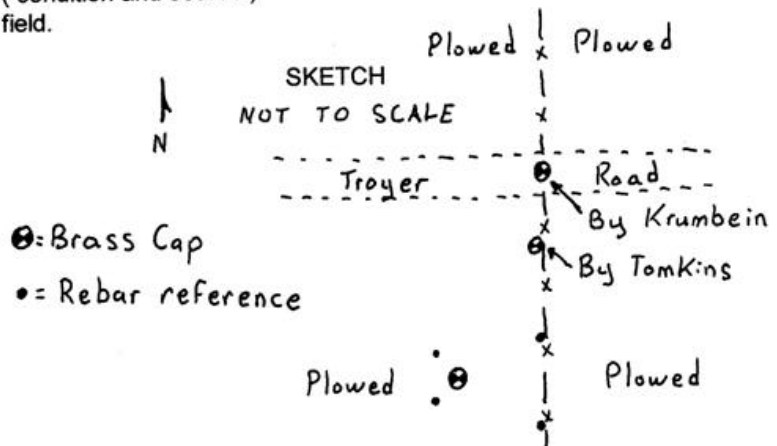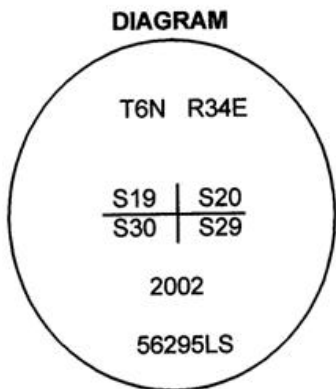

MONUMENT (S) AND ACCESSORIES SET (Procedures and Description)

I set a 1 1/2" x 30" galvanized iron pipe with a 2 1/4" brass cap stamped as shown in the diagram above 20 inches below the surface at the position calculated from Aubrey Perry's record based on his found monuments at the Northwest corner and North 1/4 corner of Section 30.

For references, I set four, 5/8" by 24" rebars with 1.25" orange plastic caps attached, stamped WTS and 56295LS as described below:

- an iron rebar bears N53°25'42"E, 76.84 feet under the existing fence;
- an iron rebar bears S45°59'28"E, 85.16 feet under the existing fence;
- an iron rebar bears N52°26'39"W, 21.78 feet 20 inches below the surface in the plowed field;
- an iron rebar bears S55°13'01"W, 21.60 feet 20 inches below the surface in the plowed field;

The monument and references were tied using a LIECA system 300 RTK GPS.

Location and comments

Compass Declination

Surveyors Seal

RECEIVED BY:
Umatilla County Surveyor
 Date: 2-03
 Rec'd By: [Signature]
 No. 03-21-C

Firm / Agency
 Haddock Surveying
 Address
 P.O. Box 1574
 Pendleton, Or. 97801
 Party Chief
 Stephen K, Haddock

REGISTERED
 PROFESSIONAL
 LAND SURVEYOR
Stephen K. Haddock
 OREGON
 JULY 9, 2001
 STEPHEN K. HADDOCK
 56295LS
 RENEWAL DATE 6-30-03