

OREGON CORNER RESTORATION FORM


Section 30 Township 6N Range 36E
 County Umatilla Date: November 21, 2007

Corner Designation: 6N36T5

Quarter corner to sections 29 and 30, T6N, R36E, W.M.
 Umatilla County, Oregon.

Condition Report Only
 Not found
 Remonumented
 Unrecorded
 Surveyed in
 Referenced out

Previous Renewals / Surveys, etc.
 The corner was originally set by Odell and Lewis under contract No. 110 dated February 7, 1865. Their record reads: Set 1/4 Sec. post. Drove charred stake; dug pits & raised mound, as per instructions. This corner was re-established by the survey recorded in the Record of Private Surveys Book 1, Page 315 but the monument was not identified.
 Monument and Accessories found: (condition and source)
 None.

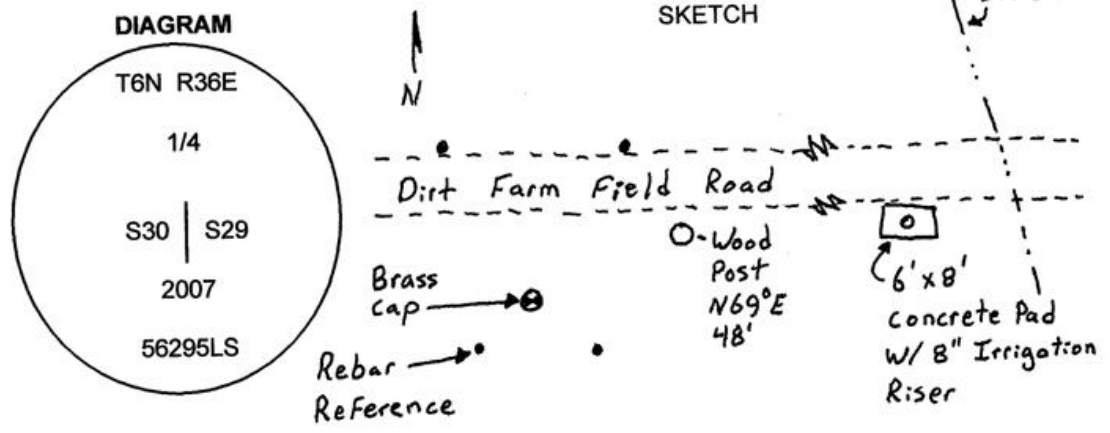

MONUMENT (S) AND ACCESSORIES SET (Procedures and Description)
 I set a 2 1/4" brass cap on a 1 1/2" x 30" galvanized iron pipe at the proportioned point. The cap was stamped as shown in the diagram above.

For references I set four 5/8" x 24" iron rebars with 1 1/8" orange plastic caps stamped WTS and 56295LS as described below:
 an iron rebar bears N26°35'05"E, 49.89 feet;
 an iron rebar bears N30°21'00"W, 52.70 feet;
 an iron rebar bears S55°31'11"E, 23.72 feet;
 an iron rebar bears S62°26'52"W, 27.68 feet;
 The center bolt of an 8" irrigation riser in a 6'x8' concrete slab bears N85°53'11"E, 266.28 feet.

The monument and references are 2' below the surface of the plowed field.
 The monument was set and references were set and tied using a Trimble R7/R8 RTK GPS

Location and comments RECEIVED BY: Umatilla County Surveyor Date: <u>02-08</u> Rec'd By: <u>[Signature]</u> No. <u>08-039-C</u>	Compass Declination Firm / Agency Witness Tree Surveying Address P.O. Box G Pilot Rock, Or. 97868 Party Chief Stephen K, Haddock	Surveyors Seal <div style="border: 1px solid black; padding: 5px; text-align: center;"> REGISTERED PROFESSIONAL LAND SURVEYOR </div> <div style="text-align: center; margin-top: 10px;"> </div> <div style="border: 1px solid black; padding: 5px; text-align: center;"> OREGON JULY 9, 2001 STEPHEN K. HADDOCK 56295LS </div> <div style="border: 1px solid black; padding: 2px; text-align: center; margin-top: 5px;"> RENEWAL DATE <u>6-30-09</u> </div>
--	---	---