

**OREGON CORNER RESTORATION FORM**

Section 33 Township 6N Range 36E  
 County Umatilla Date: November 27, 2007

Corner Designation: 6N36V11

Quarter corner common to sections 28 and 33, T6N, R36E,  
 W.M., Umatilla County, Oregon.

Condition Report Only  
 Not found  
 Remonumented  
 Unrecorded  
 Surveyed in  
 Referenced out

Previous Renewals / Surveys, etc.


Corner originally set by Odell and Lewis under contract No. 110 dated February 7, 1865. Their record reads: Set 1/4 Sec. post; dug pits & raised mound; drove charred stake as per instructions. This corner was found in the survey in the Record of Private Surveys Book 1, Page 401 but no monument was identified.

Monument and Accessories found: ( condition and source )

None: The point falls on a long term east - west berm between farm fields.

**DIAGRAM**

**SKETCH**

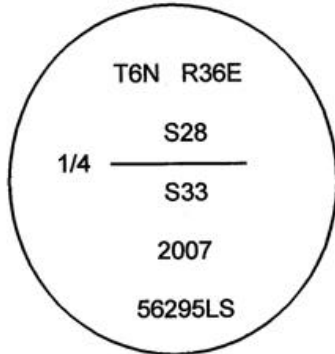

**MONUMENT (S) AND ACCESSORIES SET (Procedures and Description)**

At the position established from evidence from Book 1, Page 401 and the long time plow berm, I set a 1 1/2" x 30" galvanized iron pipe with a 2 1/4" brass cap attached stamped as shown in the diagram above.

For references, I set four 5/8" by 24" rebars with 1.25" orange plastic caps stamped WTS and 56295LS as described below:

- an iron rebar bears N44°32'37"E, 25.54 feet;
- an iron rebar bears N49°02'01"W, 26.26 feet;
- an iron rebar bears S47°59'22"W, 28.08 feet;
- an iron rebar bears S49°41'57"E, 27.49 feet;

The monument and references are 2 feet below the surface of the plowed berm.

The monument was set and references were tied using a Trimble R7/R8 RTK GPS.

Location and comments

Compass Declination

Surveyors Seal

RECEIVED BY:  
Umatilla County Surveyor  
 Date: 02-08  
 Rec'd By: [Signature]  
 No. 08-039-C

Firm / Agency  
 Witness Tree Surveying  
 Address  
 P.O. Box G  
 Pilot Rock, Or. 97868  
 Party Chief  
 Stephen K, Haddock

REGISTERED  
 PROFESSIONAL  
 LAND SURVEYOR

*Stephen K. Haddock*

OREGON  
 JULY 9, 2001  
 STEPHEN K. HADDOCK  
 56295LS

RENEWAL DATE 6-30-09