

OREGON CORNER RESTORATION FORM

Section 34 Township 6N Range 36E
 County Umatilla Date: November 26, 2007

Corner Designation: 6N36V13

Corner to sections 27, 28, 33, and 34, T6N, R36E,
 W.M., Umatilla County, Oregon.

Condition Report Only
 Not found
 Remonumented
 Unrecorded
 Surveyed in
 Referenced out


Previous Renewals / Surveys, etc.

Corner originally set by Odell and Lewis under contract No. 110 dated February 7, 1865. Their record reads: Set post Cor. for Secs. 27, 28, 33 & 34. Drove charred stake, dug pits & raised mound as per instructions. The survey in the Record of Private Surveys, Book 1, Page 401 says: Set stone 20x10x5 for cor to secs 27-28-33 & 34.

Monument and Accessories found: (condition and source)
 None. The point falls in the borrow pit of a farm field erosion control ditch.

DIAGRAM

SKETCH

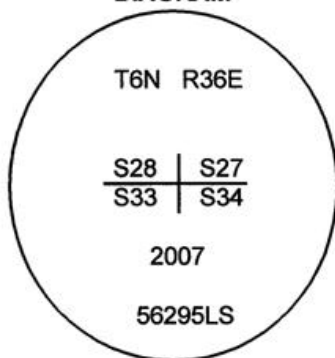

MONUMENT (S) AND ACCESSORIES SET (Procedures and Description)

I set a 1 1/2" x 30" galvanized iron pipe with a 2 1/4" brass cap stamped as shown in the diagram above by proportioning the latitude and holding the record from Book 1, Page 401 for departure.

For references, I set four, 5/8" by 24" rebars with 1 1/8" orange plastic caps attached, stamped WTS and 56295LS as described below:

- an iron rebar bears N32°52'14"W, 32.94 feet ;
- an iron rebar bears N48°21'11"E, 30.08 feet;
- an iron rebar bears S47°43'08"W, 26.85 feet;
- an iron rebar bears S35°49'34"E, 26.66 feet;

The monument and references are 2' below the surface of the plowed field.

The monument was set and references were tied using a Trimble R7/R8 RTK GPS.

Location and comments

Compass Declination

Surveyors Seal

RECEIVED BY:
Umatilla County Surveyor
 Date: 02-08
 Rec'd By: [Signature]
 No. 08-039-C

Firm / Agency
 Witness Tree Surveying
 Address
 P.O. Box G
 Pilot Rock, Or. 97868
 Party Chief
 Stephen K, Haddock

REGISTERED
 PROFESSIONAL
 LAND SURVEYOR

Stephen K. Haddock

OREGON
 JULY 9, 2001
 STEPHEN K. HADDOCK
 56295LS

RENEWAL DATE 6-30-09