

OREGON CORNER RESTORATION FORM

Section 30 Township 6N Range 36E
 County Umatilla Date: September 26, 2007

Corner Designation: 6N36V5

Corner to sections 29, 30, 31, and 32, T6N, R36E,
 W.M., Umatilla County, Oregon.

Condition Report Only
 Not found
 Remonumented
 Unrecorded
 Surveyed in
 Referenced out


Previous Renewals / Surveys, etc.

Corner originally set by Odell and Lewis under contract No. 110 dated February 7, 1865. Their record reads: Set post Cor. for Secs. 29, 30, 31 & 32. Drove charred stake, dug pits & raised mound as per instructions. This corner was tied by the Union Pacific Railroad and the surveys in the Record of Private Surveys Book 1, Pages 315 and 402 but no monument identification was given.

Monument and Accessories found: (condition and source)
 None. The point falls in a plowed field.

DIAGRAM

SKETCH

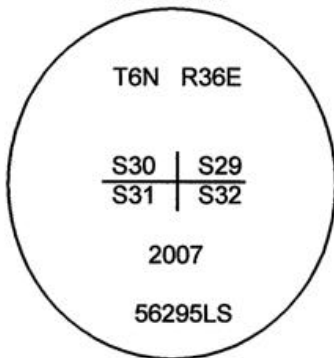

MONUMENT (S) AND ACCESSORIES SET (Procedures and Description)

I set a 1 1/2" x 30" galvanized iron pipe with a 2 1/4" brass cap stamped as shown in the diagram above holding record data from the U.P.R.R. map and survey Book 1, Page 402.

For references, I set four, 5/8" by 24" rebars with 1 1/8" orange plastic caps attached, stamped WTS and 56295LS as described below:

- an iron rebar bears N52°21'50"W, 23.91 feet ;
- an iron rebar bears N52°17'15"E, 24.17 feet;
- an iron rebar bears S51°11'39"W, 23.86 feet;
- an iron rebar bears S46°56'03"E, 23.53 feet;

The monument and references are 2' below the surface of the plowed field.

The monument was set and references were tied using a Trimble R7/R8 RTK GPS.

Location and comments

Compass Declination

Surveyors Seal

RECEIVED BY:
Umatilla County Surveyor
 Date: 02-08
 Rec'd By: [Signature]
 No. 08-039-C

Firm / Agency
 Witness Tree Surveying
 Address
 P.O. Box G
 Pilot Rock, Or. 97868
 Party Chief
 Stephen K, Haddock

REGISTERED
 PROFESSIONAL
 LAND SURVEYOR

Stephen K. Haddock

OREGON
 JULY 9, 2001
 STEPHEN K. HADDOCK
 56295LS

RENEWAL DATE 6-30-09