


COMPASS DECLINATION: 15° East

SURVEYORS' SEAL:

**FIRM:** HDJ Design Group  
5 N. Colville, Suite 200  
Walla Walla WA 99362

**WITNESSES:** Thomas J. Boshart  
Felipe G. Hernandez  
Joseph R. Latimer  
Cory A. West

REGISTERED  
PROFESSIONAL  
LAND SURVEYOR

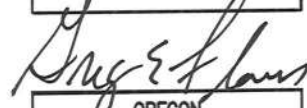

OREGON  
JUNE 30, 1997  
GREG E. FLOWERS  
02820LS

RENEWS 12/31/15

06/29/2015

## OREGON CORNER RESTORATION FORM

COUNTY: Umatilla    DATE: 2/17/2015

**CORNER DESIGNATION:** N-9, Corner of Sections 16, 17, 21 and 22, Township 6 North, Range 37E, W.M.

**PREVIOUS RENEWALS/SURVEYS ETC:**

Originally surveyed by A. H. Simmons for US Deputy Surveyor George Williams under his contract No. 176 dated July 20, 1872. His notes state "Set stone 6 x 8 x 13, mound and pits for the Cor. to Secs. 16, 17, 20 and 21."

Surveyor Paul W.P. Tomkins noted in his September 28, 1992 survey, shown on Umatilla County Survey record of surveys 92-122-B, "Held fence corner as best evidence of section corner, searched for stone, not found.

Surveyor Paul W.P. Tomkins noted in his April 9, 2001 survey, shown on Umatilla County Survey record of surveys 01-64-B, "Fence corner at N.E. corner Sec. 20, 21 per Survey 92-122-B."

Surveyor Paul W.P. Tomkins noted in his January 8, 2005 survey, shown on Umatilla County Survey Record of Plats 2005-02, "Held fence corner for N.E. Corner Sec. 20, originally tied on Survey 92-122-B."

Surveyor Paul W.P. Tomkins noted in his October 14, 2008 survey, shown on Umatilla County Survey Record of Plats 2008-29, "Fence Corner at NE Corner, Sec. 20, per Survey 92-122-B."

**MOUNUMENT AND ACCESSORIES FOUND:**

Barbed wire fence intersection N., S., and E., located at fence post.

**MOUNUMENT MARKING DETAIL:**

LS 02820  
T 6N R 37E  

S 17	S 16
S 20	S 21

  
2/2015

**MOUNUMENT AND ACCESSORIES SET:**

At the NE Corner of the fence post, set a 2½ ins. brass cap on a 1½ in. galvanized iron pipe, 4 ins. above ground, 3 ins. W. of existing barbed wire fence post, from which:

Set a 5/8" iron rebar with yellow plastic cap marked "TLS-HDJ" bears N. 50° W., 16.00 ft.

Set a 5/8" iron rebar with yellow plastic cap marked "TLS-HDJ" bears N. 44° E., 22.00 ft.

Set a 5/8" iron rebar with yellow plastic cap marked "TLS-HDJ" bears S. 45° E., 18.00 ft.

Set a 5/8" iron rebar with yellow plastic cap marked "TLS-HDJ" bears S. 43° W., 14.00 ft.

**LOCATION AND COMMENTS:**

Corner is on a South facing moderate slope, approximately midway on slope between East/West running ridge top and ravine below. Bearings taken with Silva hand compass and distances measured with a steel tape.

**OREGON STATE PLANE COORDINATE, North Zone, NAD 83(91), International Feet:**

N = 855799.73

E = 8785416.50