


CERTIFIED RECORD OF LAND CORNER MONUMENTATION

History of original corner establishment:

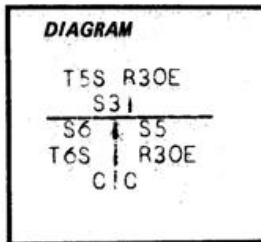

PINE POST

- 18" PINE S59E 130LKS.
- 30" PINE S53W 61LKS.
- 30" PINE N25E 92LKS.

Description of corner evidence found:

- 34" SNAG N25E SCRIBING CLEARLY VISIBLE
- STUMP S53W SCRIBING VISIBLE
- STUMP S59E SCRIBING VISIBLE

Description of monument and accessories I established to perpetuate the original location of this corner:


SET A 2"x30" IRON PIPE WITH A BRASS-CAP MARKED: CORNER MONUMENT IS SET IN MOUND OF STONES.

- 8" FIR S60E 49.5' MARKED: T6S R30E S5 CC BT
- 14" PINE S19W 137.4 MARKED: T6S R30E S6 CC BT

ALL OLD BT'S HAVE A BEARING TREE TAG. THE NEW BT'S AND THE STANDING SNAG HAVE A RED PAINTED STRIPE, A BEARING TREE SIGN, AND AN ATTENTION SIGN. THE NEW BT'S ALSO HAVE BRASS WASHER STAMPED PLS 346 NAILED TO THE LOWER BLAZE. THERE ARE STEEL FENCE POSTS SET ON LINE NEAR THE CORNER.

NOTE: THE ORIGINAL BEARING AND DISTANCES DO NOT MATCH UP WITH THE CURRENT ONES FOR THE CORNER SET:

- 18" PINE S59E 130LKS(185.8') BECOMES S59E 67.8
- 30" PINE S53W 61LKS(40.3') BECOMES S53W 42.0
- 30" PINE N25E 92LKS(60.7') BECOMES N25E 15.2'

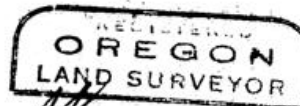

*Wayne O. Harris*  
MAY 6, 1955  
WAYNE O. HARRIS  
346

Office of..... COUNTY SURVEYOR..... County of..... UMATILLA  
State of..... OREGON..... I hereby certify that the within instrument was filed in this office  
for record on the 21 day of SEPTEMBER, 1978  
*Wayne O. Harris* by.....  
(COUNTY OFFICIAL) (DEPUTY)

A-5