

USDA-FOREST SERVICE

Index
File No. A-9

CORNER RECORD (SEARCH)

(Ref. FSM 7151.4)

Tract or
Survey No. _____
Cor.
No. CC


T 6S R. 30E

R.D. UKIAH County UMATILLA

Merid. _____

N.F. UMATILLA State OR

CORNER DIAGRAM

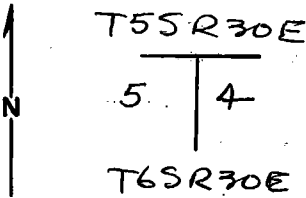

DESCRIBE CORNER MONUMENT FOUND

NONE

DESCRIBE BEARING TREES OR OTHER OFFICIAL ACCESSORIES FOUND

A 31" PINE STUMP BR5 N12°W 469 FT MKD "B"
Remains of a DEAD & DOWN 28" PINE BR5 SAPE 389 FT.
A 34" PINE BR5 S47°W 593 FT MKD R30ET6S ON OLD FIRE SCAR.

PHOTO IDENTIFICATION DATA

Photo No. _____
Filed At. _____
Object Ident. _____
Ident. By _____
Signature

DESCRIBE CORNER LOCATION RELATIVE TO NEAR-BY FEATURES, ALSO HOW TO REACH CORNER

COR. IS 8' N. OF OLD FENCE RUNNING E & W

PLANE COORDINATE POSITION DATA

State _____ Zone _____
X _____
Y _____
Estab. By _____
Agency

Signature
R.D. Banta

Title
LAND SURVEYOR

Division _____ Headquarters _____

Date
9-30-76

7100-52-(3/68)

CORNER RECORD (PERPETUATION)

MONUMENT: DESCRIBE NEW MONUMENT SET, OR WORK DONE TO PRESERVE EXISTING MONUMENT

SET 2 1/2" x 30" IRON PIPE w/ BRASS CAP MKD

T55R30E
S32
35 | 54
T6S R30E
1976
OPLS 598

9

ACCESSORIES: DESCRIBE NEW BT'S WITNESS OBJECTS ETC. ESTABLISHED, OR WORK DONE TO PRESERVE EXISTING EVIDENCE

NEW BT'S

A 10" FIR BR3 S32°E 213 FT MKD T6SR30E S4 CC BT

A 20" FIR " S21°W 312 " " T6SR30E S5 CC BT

10

Work Done By: R.D. Begett Title LAND SURVEYOR Date 9-30-76 State Registration No. OPLS 598
or Agency

Certified Cor. Record Prepared? Yes No Filed At: UMATILLA CO. Date

11

REMARKS

Index File No. A-9 T. R. M. Tract or Surv. No. Cor.

12

13