


CERTIFIED RECORD OF LAND CORNER MONUMENTATION

B-19

History of original corner establishment:

Unsurveyed - subdivided section

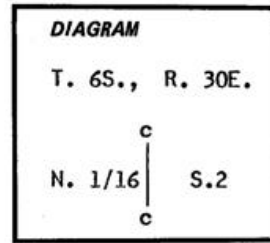

No record of subsequent remonumentation found in County Record.

Description of corner evidence found:


None.

Description of monument and accessories I established to perpetuate the original location of this corner:

Set 2 1/2" x 30" iron pipe 26" in ground with brass cap marked as shown: From which I scribed Bearing Trees.

A 11" fir bears S. 82°20' W. 14.3 ft. mkd. CN 1/16 S.2 BT.  
A 7" fir bears S. 80°47' E. 14.0 ft. mkd. CN 1/16 S.2 BT.

Nailed a brass washer mkd. PLS 933 to the BT blaze on both trees. Set steel fence post 2 ft. East of corner. Used transit and steel tape, measuring to the center of BTs.

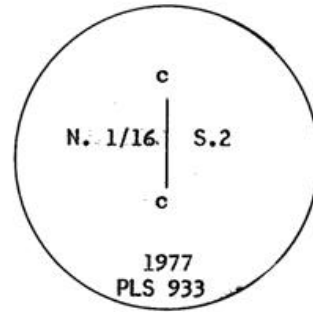

Office of.....County Surveyor..... County of.....**Umatilla**.....  
State of.....**Oregon**....., I hereby certify that the within instrument was filed in this office  
for record on the.....day of....., 19.....  
*David H. Krumbein*..... by.....  
(COUNTY OFFICIAL) (DEPUTY)

B-19