


C-14

CERTIFIED RECORD OF LAND CORNER MONUMENTATION

History of original corner establishment:  
Unsurveyed - subdivided section

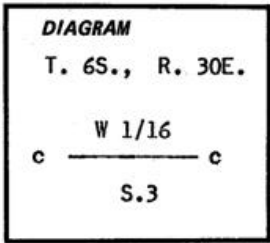

No record of subsequent remonumentation found in County Records.

Description of corner evidence found:


None.

Description of monument and accessories | established to perpetuate the original location of this corner:

Set 2 1/2" x 30" iron pipe 24" inground with brass cap marked as shown:  
From which I scribed Bearing Trees.

A 8" fir bears N. 75°13' W. 24.3 ft. mkd. CW 1/16 S.3 BT.  
A 8" fir bears S. 31°26' W. 37.2 ft. mkd. CW 1/16 S.3 BT.

Nailed a brass washer mkd. PLS 933 to the BT blaze of both trees. Set a steel fence post 3 ft. East of corner. Raised mound of stone. Used transit and steel tape, measuring to the center of BTs.

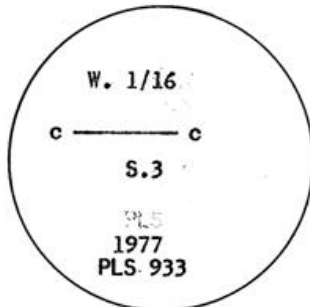

Office of.....County Surveyor..... County of.....Umatilla.....  
 State of.....Oregon....., I hereby certify that the within instrument was filed in this office  
 for record on the..... day of....., 19.....  
*David H. Krumbein* by.....  
 (COUNTY OFFICIAL) (DEPUTY)

C-14

71-64