

USDA-FOREST SERVICE

Index File No. C-15

CORNER RECORD (SEARCH)

(Ref. FSM 7151.4)

Tract or Survey No. _____ Cor. No. _____


T 6S. R. 30E.

R.D. Ukiah County Umatilla

Merid. Willamette

N.F. Umatilla State Oregon

CORNER DIAGRAM

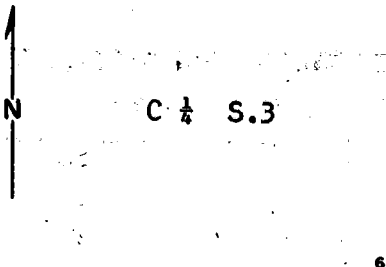

DESCRIBE CORNER MONUMENT FOUND

None.

Set brass cap

DESCRIBE BEARING TREES OR OTHER OFFICIAL ACCESSORIES FOUND

None.

PHOTO IDENTIFICATION DATA

Photo No. _____

Filed At. _____

Object Ident. _____

Ident. By _____

Signature

PLANE COORDINATE POSITION DATA

State _____ Zone _____

X _____

Y _____

Estab. By _____

Agency

DESCRIBE CORNER LOCATION RELATIVE TO NEAR-BY FEATURES, ALSO HOW TO REACH CORNER

From the intersection of U.S. Forest Road 419N and 537N, go East along 537N, about 2.3 miles, then walk West about 45.4 chns. to the corner

Signature
David H Klein

Title SOILS Division (S&C) Headquarters (Dist)

OPLS

Headquarters (Dist)

933

Date

7-77

7100-52-(3/68)

U.S. GOVERNMENT PRINTING OFFICE: 1968 O 350-000

CORNER RECORD (PERPETUATION)

MONUMENT: DESCRIBE NEW MONUMENT SET, OR WORK DONE TO PRESERVE EXISTING MONUMENT

T. 6S., R. 30E.

Set 2½" x 30" iron pipe with brass cap

C ¼ S.3

Pipe is 12" in ground.

Mound of stone to cap.

1977

Stamped as shown:

PLS 933

9

ACCESSORIES: DESCRIBE NEW BT'S WITNESS OBJECTS ETC. ESTABLISHED, OR WORK DONE TO PRESERVE EXISTING EVIDENCE

A 9" pine bears N. 18° W. 43.6 ft.

A 9" pine bears S. 34° W. 45.5 ft.

Set steel fence post 3' West of brass cap w/sign.

Painted red band around bearing trees w/sign.

10

Work Done By T. Hamby Title Party Chief Date 6/23/77 State Registration No. _____ or Agency _____Certified Cor. Record Prepared? Yes No Filed At: _____ Date _____ 11

REMARKS

Index File No. T. R. M. Tract or Surv. No. Cor. 12 13