

USDA-FOREST SERVICE

Index File No. C-18

T 6S. R. 30E.

Merid. Willamette

CORNER RECORD (SEARCH)


(Ref. FSM 7151.4)

R.D. Ukiah County Umatilla

N.F. Umatilla State Oregon

Tract or Survey No. _____ No. _____

CORNER DIAGRAM

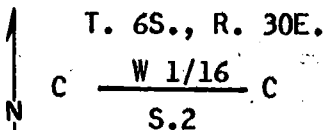

DESCRIBE CORNER MONUMENT FOUND

None
Set brass cap

DESCRIBE BEARING TREES OR OTHER OFFICIAL ACCESSORIES FOUND

None

PHOTO IDENTIFICATION DATA

Photo No. _____

Filed At. _____

Object Ident. _____

Ident. By _____

Signature

PLANE COORDINATE POSITION DATA

State _____ Zone _____

X _____

Y _____

Estab. By _____

Agency

DESCRIBE CORNER LOCATION RELATIVE TO NEAR-BY FEATURES, ALSO HOW TO REACH CORNER

From intersection of U.S. Forest Road 419 N and 537N, go East 2.8 miles and then walk East 7.5 chns. to corner.

Signature
David H. Hiles

Title

Division
OPLS

Headquarters
933

Date
7-77

7100-52-(3/68)

CORNER RECORD (PERPETUATION)

MONUMENT: DESCRIBE NEW MONUMENT SET, OR WORK DONE TO PRESERVE EXISTING MONUMENT

Set 2 1/2" x 30" iron pin with brass cap.

W 1/16
C _____ C

Pipe is 26" in ground.

S.2
1977
PLS 933

Stamped:

ACCESSORIES: DESCRIBE NEW BT'S WITNESS OBJECTS ETC. ESTABLISHED, OR WORK DONE TO PRESERVE EXISTING EVIDENCE

A 9" pine bears N. 48°21' W. 41.0 ft.

A 8" fir bears S. 21°56' E. 22.1 ft.

Set steel fence post 2 ft. East of corner w/sign.

Painted red band around BT trees w/sign.

Work Done By T. Hamby Title Party Chief Date 6/23/77 State Registration No. _____
or Agency _____

Certified Cor. Record Prepared? Yes No _____ Filed At: _____ Date _____

REMARKS

Index File No. T. R. M. Tract or Surv. No. Cor. _____