


CERTIFIED RECORD OF LAND CORNER MONUMENTATION

C-20

History of original corner establishment:

Unsurveyed - subdivided section

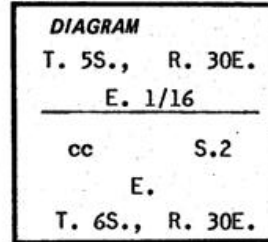

No record of subsequent remonumentation found in County Record.

Description of corner evidence found:


None.

Description of monument and accessories I established to perpetuate the original location of this corner:

Set 2 1/2" x 30" iron pipe 15" in ground with a brass cap marked as shown. From which I scribed Bearing Trees:

- A 10" fir bears S. 33°47' E. 54.9 ft. mkd. E. 1/16 CC S.2 BT.
- A 10" fir bears S. 39°17' W. 25.6 ft. mkd. E. 1/16 CC S.2 BT.

Nailed a brass washer mkd. P.L.S. 933 on the BT blaze on both trees. Set a steel fence post 3.5 ft. East of corner. The corner is 14 ft. South of a E-W fence line. Raised mound of stone 3 ft. base within 3" of top of pipe. Used transit and steel tape, measuring to center of BTs.

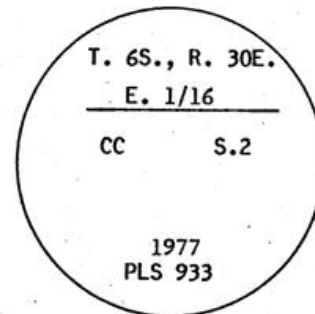

Office of.....County Surveyor..... County of.....Umatilla.....  
 State of.....Oregon....., I hereby certify that the within instrument was filed in this office  
 for record on the..... day of....., 19.....  
*David H. Krumbain*..... by.....  
 (COUNTY OFFICIAL) (DEPUTY)

C-20

S-160-R

S-160