


History of original corner establishment:
Unsurveyed - subdivided section

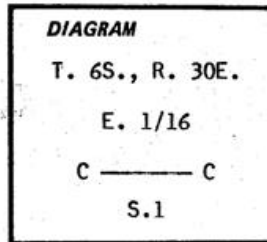


No record of subsequent remonumentation found in County Records.
Description of corner evidence found:
None.

Description of monument and accessories I established to perpetuate the original location of this corner:

Set 2 1/2" x 30" iron pipe 8" in ground with a brass cap marked as shown:
From which I scribed Bearing Trees.

A 11" pine bears S. 75°25' E. 24.1 ft. mkd. C E 1/16 S.1 BT.
A 11" pine bears S. 49°05' W. 47.8 ft. mkd. C E 1/16 S.1 BT.

Nailed a brass washer mkd. PLS 933 to BT blaze on both trees. Set a steel post 2 ft. East of corner. Raised mound of stone 3 ft. base within 4" of top of pipe. Used transit and steel tape, measuring to center of BTs.

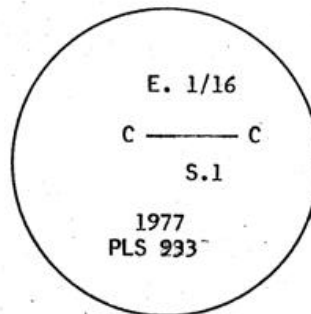

Office of..... County Surveyor..... County of..... Umatilla.....
State of..... Oregon..... I hereby certify that the within instrument was filed in this office
for record on the..... day of....., 19.....
David H. Krumbein..... by.....
(COUNTY OFFICIAL) (DEPUTY)

C-24