


D-13

History of original corner establishment:

Unsurveyed - subdivided section

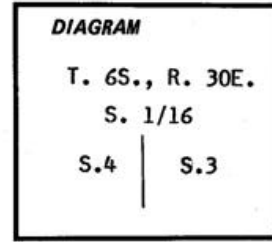

No record subsequent remonumentation found in County Records.

Description of corner evidence found:


None.

Description of monument and accessories I established to perpetuate the original location of this corner:

Set 2 1/2" x 30" iron pipe 26" in ground with brass cap marked as shown. From which I scribed New Bearing Trees.

A 13" pine bears N. 45° W. 29.7 ft. mkd. T. 6S., R. 30E., S. 1/16 S.4 BT.
A 12" fir bears S. 74° E. 40.2 ft. mkd. T. 6S., R. 30E., S. 1/16 S.3 BT.

I nailed a brass washer mkd. PLS 933 to the BT blaze of both trees. Set a steel fence post 2 ft. West of corner. Corner is 80 ft. West of N-S fence. Used transit and steel tape, measuring to the center of new BT.

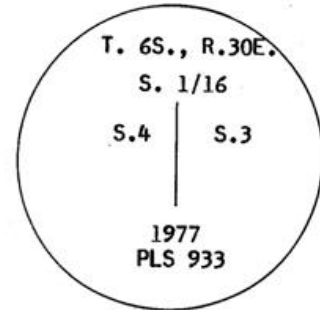

Office of County Surveyor County of Umatilla
State of Oregon I hereby certify that the within instrument was filed in this office
for record on the day of , 19
David H. Krumbein by
(COUNTY OFFICIAL) (DEPUTY)

D-13

m-66 1