


D-14

CERTIFIED RECORD OF LAND CORNER MONUMENTATION

History of original corner establishment:

Unsurveyed - subdivided section

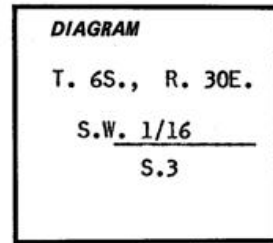

No record of subsequent remonumentation found in County Record.

Description of corner evidence found:


None.

Description of monument and accessories I established to perpetuate the original location of this corner:

Set 2½" x 30" iron pipe 15" in the ground with brass cap marked as shown:  
From which I scribed Bearing Trees.

A 8" fir bears N. 34°22' W. 29.8 ft. mkd. SW 1/16 S.3 BT.  
A 8" pine bears S. 09°07' W. 34.9 ft. mkd. SW 1/16 S.3 BT.

Nailed a brass washer PLS 933 to the BT blaze of both trees. Set a steel fence post 4 ft. East of corner. Raised mound of stone 3 ft. base within 3" of top of pipe. Corner is South of old road. Used transit and steel tape, measuring to the center of BTs.

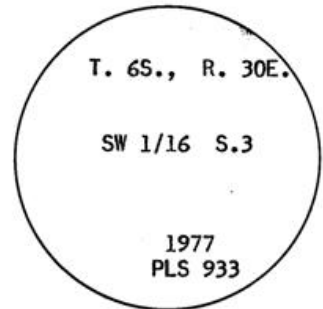

Office of.....County Surveyor..... County of.....Umatilla.....  
 State of.....Oregon..... I hereby certify that the within instrument was filed in this office  
 for record on the..... day of....., 19.....  
*M. O. Davis* by.....  
 (COUNTY OFFICIAL) (DEPUTY)

D-14

m-64