


History of original corner establishment:

Unsurveyed - subdivided section

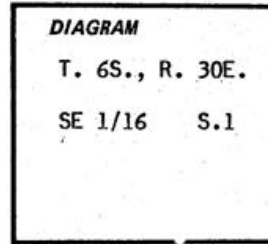

No record of subsequent remonumentation found in County Record.

Description of corner evidence found:


None.

Description of monument and accessories I established to perpetuate the original location of this corner:

Set 2 1/2" x 30" iron pipe 25" in ground with brass cap marked as shown. From which I scribed Bearing Trees:

A 16" fir bears S. 22°E. 36.4 ft. mkd. SE 1/16 S.1 BT.
A 16" fir bears S. 68°W. 53.2 ft. mkd. SE 1/16 S.1 BT.

Nailed brass washer mkd. PLS 933 to BT blaze on both trees. Set a steel fence post 3 ft. East of corner. Used transit and steel tape, measuring to the center of BTs.

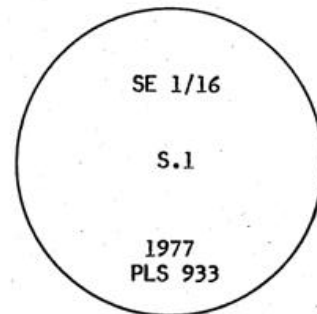

Office of.....County Surveyor..... County of.....Umatilla.....
 State of.....Oregon....., I hereby certify that the within instrument was filed in this office
 for record on the..... day of....., 19.....
M. O. Davis..... by.....
 (COUNTY OFFICIAL) (DEPUTY)

D-24