


History of original corner establishment:

Unsurveyed - subdivided section

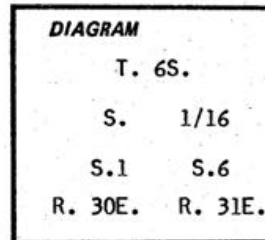

No record of subsequent remonumentation found in County Record.

Description of corner evidence found:


None.

Description of monument and accessories I established to perpetuate the original location of this corner:

Set 2 1/2" x 30" iron pipe 23" in ground with brass cap marked as shown: From which I scribed Bearing Trees.

A 30" pine bears N. 69° E. 85.4 ft. mkd. T. 6S., R. 31 E. S. 1/16 S.6 BT.  
A 25" pine bears S. 58°32' W. 95.6 ft. mkd. T. 6S., R. 30 E. S. 1/16 S.1 BT.

Nailed brass washer mkd. PLS 933 to BT blaze on both trees. Set a steel fence post 2 ft. west of corner. Corner is on North edge of E-W road. Used transit and steel tape, measuring to the center of BTs.

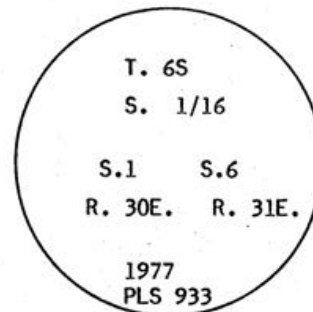

Office of.....County Surveyor..... County of.....Umatilla.....  
 State of.....Oregon....., I hereby certify that the within instrument was filed in this office  
 for record on the..... day of....., 19.....  
*M. O. Harris*..... by.....  
 (COUNTY OFFICIAL) (DEPUTY)

D-25