

USDA-FOREST SERVICE

Index File No. D-25


CORNER RECORD (SEARCH)  
(Ref. FSM 7151.4)

Tract or Survey No. \_\_\_\_\_ Cor. No. \_\_\_\_\_

T 6S. R. 30E. R.D. Ukiah County Umatilla

Merid. Willamette N.F. Umatilla State Oregon

CORNER DIAGRAM

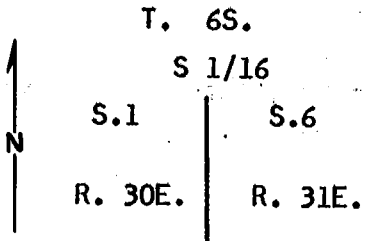

DESCRIBE CORNER MONUMENT FOUND

None  
set brass cap

DESCRIBE BEARING TREES OR OTHER OFFICIAL ACCESSORIES FOUND

None

PHOTO IDENTIFICATION DATA

Photo No. \_\_\_\_\_  
Filed At. \_\_\_\_\_  
Object Ident. \_\_\_\_\_  
Ident. By \_\_\_\_\_  
Signature \_\_\_\_\_

DESCRIBE CORNER LOCATION RELATIVE TO NEAR-BY FEATURES, ALSO HOW TO REACH CORNER

From the intersection of Highway 395 and road up Five Mile Creek, go up the Five Mile Creek Road about 5.0 miles, then West 0.2 miles to the corner.

PLANE COORDINATE POSITION DATA

State \_\_\_\_\_ Zone \_\_\_\_\_  
X \_\_\_\_\_  
Y \_\_\_\_\_  
Estab. By \_\_\_\_\_  
Agency \_\_\_\_\_

Signature  
*David H. Miller*

Title

Division  
OPLS

Headquarters  
933

Date  
7-77

7100-52-(3/68)

## CORNER RECORD (PERPETUATION)

MONUMENT: DESCRIBE NEW MONUMENT SET, OR WORK DONE TO PRESERVE EXISTING MONUMENT

Set 2½" x 30" iron pipe with brass cap.  
Pipe is 23" in ground.

T. 6S.  
S. 1/16  
S.1 S.6  
R. 30E. R. 31E.

Stamped:

1977  
PLS 933

9

ACCESSORIES: DESCRIBE NEW BT'S WITNESS OBJECTS ETC. ESTABLISHED, OR WORK DONE TO PRESERVE EXISTING EVIDENCE

A 30" pine bears N. 69° E. 85.4 ft.  
A 25" pine bears S. 58° 32' W. 95.6 ft.

Set steel fence post 2 ft. West of corner w/sign.  
Painted red band around BT trees w/sign.

10

Work Done By T. Hamby Title Party Chief Date 6/23/77 State Registration No. \_\_\_\_\_  
Certified Cor. Record Prepared? Yes  No \_\_\_\_\_ Filed At: \_\_\_\_\_ Date \_\_\_\_\_

11

REMARKS

12

Index File No. T. R. M. Tract or Surv. No. Cor. 13