

USDA-FOREST SERVICE

Index File No. E-14

CORNER RECORD (SEARCH)


(Ref. FSM 7151.4)

Tract or Survey No. _____ Cor. No. _____

T 6S. R. 30E. R.D. Ukiah County Umatilla

Merid. Willamette N.F. Umatilla State Oregon

CORNER DIAGRAM

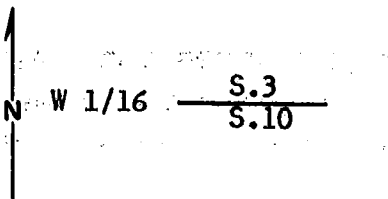

DESCRIBE CORNER MONUMENT FOUND

None
Set brass cap

DESCRIBE BEARING TREES OR OTHER OFFICIAL ACCESSORIES FOUND

None

PHOTO IDENTIFICATION DATA

Photo No. _____
Filed At. _____
Object Ident. _____
Ident. By _____
Signature

DESCRIBE CORNER LOCATION RELATIVE TO NEAR-BY FEATURES, ALSO HOW TO REACH CORNER

From the intersection of U.S. Forest Road 419N and 537N, go East along 537N 3.3 miles, then turn right and go 1/5 miles, and the corner is 480 ft. North of Road.

PLANE COORDINATE POSITION DATA

State _____ Zone _____
X _____
Y _____
Estab. By _____
Agency

Signature
David H. Kn

Title COOPER DIVISION Headquarters OPLS
933

Date
7-77

7100-52-(3/68)

CORNER RECORD (PERPETUATION)

MONUMENT: DESCRIBE NEW MONUMENT SET, OR WORK DONE TO PRESERVE EXISTING MONUMENT

T. 6S., R. 30E.

Set 2 1/2" x 30" iron pipe with brass cap.

Pipe is 16" in ground.

Mound of stone to cap.

W 1/16 — $\frac{S.3}{S.10}$

Stamped as shown:

1977
PLS 933

ACCESSORIES : DESCRIBE NEW BT'S: WITNESS OBJECTS ETC. ESTABLISHED, OR WORK DONE TO PRESERVE EXISTING EVIDENCE

A 10" pine N. 39°04' E. 38.5 ft.

A 10" pine S. 16°57' W. 31.5 ft.

Set steel fence post 3' East of brass cap w/sign.

Painted red band around bearing trees w/sign.

10

Work Done By T. Hamby Title Party Chief Date 6/23/77 State Registration No. _____
or Agency _____Certified Cor. Record Prepared? Yes No Filed At: _____ Date _____ 11

REMARKS

Index File No. T. R. M. Tract or Surv. No. Cor. 12 13