

USDA-FOREST SERVICE

Index File No. E-15

CORNER RECORD (SEARCH)

(Ref. FSM 7151.4)

Tract or Survey No. \_\_\_\_\_

Cor. No. \_\_\_\_\_


T 6S. R. 30E

R.D. Ukiah County Umatilla

Merid. Willamette

N.F. Umatilla State Oregon

CORNER DIAGRAM

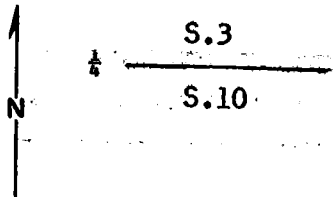

DESCRIBE CORNER MONUMENT FOUND

None

*Set brass cap*

DESCRIBE BEARING TREES OR OTHER OFFICIAL ACCESSORIES FOUND

17" pine bears N. 26°53' W. 35.10 ft. mkd. with a  $\frac{1}{4}$  (old BT)

PHOTO IDENTIFICATION DATA

Photo No. \_\_\_\_\_

Filed At. \_\_\_\_\_

Object Ident. \_\_\_\_\_

Ident. By \_\_\_\_\_

*Signature*

PLANE COORDINATE POSITION DATA

State \_\_\_\_\_ Zone \_\_\_\_\_

X \_\_\_\_\_

Y \_\_\_\_\_

Estab. By \_\_\_\_\_

*Agency*

DESCRIBE CORNER LOCATION RELATIVE TO NEAR-BY FEATURES, ALSO HOW TO REACH CORNER

From the intersection of U.S. Forest Road 419N and 537N, go East 3.3 miles to road sign (which says Deerhorn), then go West 1 mile, corner is 30 ft. North of road.

*Signature*  
*David H. Keller*

Title

*COOPER Division*  
*OPLS*

Headquarters

*933*

Date

*7-77*

7100-52-(3/68)

CORNER RECORD (PERPETUATION)

MONUMENT: DESCRIBE NEW MONUMENT SET, OR WORK DONE TO PRESERVE EXISTING MONUMENT

T. 6S., R. 30E.

Set 2 1/2" x 30" iron pipe wth brass cap.  
Pipe is 18" in ground.  
Mound of stone to cap.

1/4 S.3  
S.10

1977  
PLS 933

Stamped as shown:

9

ACCESSORIES: DESCRIBE NEW BT'S WITNESS OBJECTS ETC. ESTABLISHED, OR WORK DONE TO PRESERVE EXISTING EVIDENCE

A 12" pine bears S. 47°04' E. 60.5 ft.  
A 18' pine bears N. 45°27' W. 81.0 ft.

Set steel fence post 5' East of brass cap w/sign.  
Painted red band around bearing trees w/sign.

10

Work Done By T. Hamby Title Party Chief Date 6/23/77 State Registration No. \_\_\_\_\_  
or Agency \_\_\_\_\_

Certified Cor. Record Prepared? Yes  No  Filed At: \_\_\_\_\_ Date \_\_\_\_\_

11

REMARKS

Index File No. T. R. M. Tract or Surv. No. Cor. 12  
13