

USDA-FOREST SERVICE

Index File No. J-22

CORNER RECORD (SEARCH)

(Ref. FSM 7151.4)

Tract or Survey No. \_\_\_\_\_ No. \_\_\_\_\_


T 6S R. 30E

R.D. UKIAH County UMATILLA

Merid. WILLAMETTE

N.F. UMATILLA State OREGON

CORNER DIAGRAM

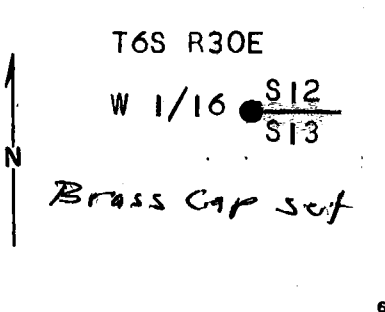

DESCRIBE CORNER MONUMENT FOUND

NONE

DESCRIBE BEARING TREES OR OTHER OFFICIAL ACCESSORIES FOUND

NONE

PHOTO IDENTIFICATION DATA

Photo No. \_\_\_\_\_

Filed At. \_\_\_\_\_

Object Ident. \_\_\_\_\_

Ident. By \_\_\_\_\_

Signature \_\_\_\_\_

DESCRIBE CORNER LOCATION RELATIVE TO NEAR-BY FEATURES, ALSO HOW TO REACH CORNER

CORNER IS NEAR POINT OF RIDGE. A ROAD RUNS WITHIN 25' NORTH OF CORNER. THERE IS A LOCATION TAG ON ROAD.

PLANE COORDINATE POSITION DATA

State \_\_\_\_\_ Zone \_\_\_\_\_

X \_\_\_\_\_

Y \_\_\_\_\_

Estab. By \_\_\_\_\_

Agency \_\_\_\_\_

Signature Wayne O. Harris Title Co. Surveyor Division \_\_\_\_\_ Headquarters \_\_\_\_\_ Date \_\_\_\_\_ 7100-52-(3/68)

CORNER RECORD (PERPETUATION)

MONUMENT: DESCRIBE NEW MONUMENT SET, OR WORK DONE TO PRESERVE EXISTING MONUMENT

SET 3" x 30" IRON PIPE WITH BRASS CAP MARKED:

T6S R30E  
W 1/16 S12  
          S13  
1978  
PLS 346

ACCESSORIES : DESCRIBE NEW BT'S WITNESS OBJECTS ETC. ESTABLISHED, OR WORK DONE TO PRESERVE EXISTING EVIDENCE

14" PINE S56W 197<sup>7</sup> MARKED W1/16 S13 BT  
16" PINE N02W 32<sup>7</sup> MARKED W1/16 S12 BT  
BOTH BT'S HAVE A RED PAINTED STRIPE, BT AND ATTENTION SIGNS, AND  
A BRASS WASHER STAMPED PLS 346 NAILED TO LOWER BLAZE

Work Done By W.O. HARRIS Title \_\_\_\_\_ Date 10/12/78 State Registration No. PLS 346  
Agency \_\_\_\_\_

Certified Cor. Record Prepared ? Yes No Filed At: \_\_\_\_\_ Date \_\_\_\_\_

REMARKS

A FENCE CORNER IS APX 20' N45E