

U. S. Department of Agriculture
FOREST SERVICE

NATIONAL FOREST

CORNERS OF THE PUBLIC SURVEY

T. 6 S R. 30 E Mer.

14 Corner common to Sections

16, and 24

Corner consists of a pine post (not) in place


State condition _____

Dimensions above ground _____ inches.

Sketch grooves, letters, figures, or notches, on proper face or edge.

CARDINAL POSITION

DIAGONAL POSITION

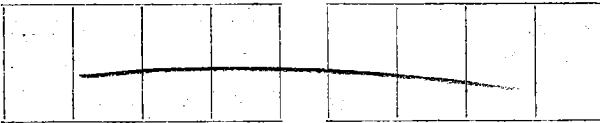

N W S E NW SW SE NE

Mound of _____ is located _____

Pits are located _____

Sketch markings of Bearing Trees (or Rocks) in proper box and fill blanks below, giving bearings from Corner to Trees and Distances in Links.

TGS
N 30 E
165

BL

Species PP

Diameter 28

Bearing _____

Distance _____

Do you believe this to be a genuine Land Office Corner? ...

If not, why? yes

4/19/52 Arthur D. ...
(Date) (Signature)
Forester
(Title)

T. _____ R. _____ Mer.

(Make sketch of topography near Corner and show section line markers thus "X")

Sec.		Sec.	
Sec.		Sec.	

Metal Location Poster is on a _____

tree _____ inches diameter, on the _____

side of _____ from which

this Corner bears _____ Chains.

(Bearing) (Distance)

Section line marker between Secs. _____ and _____ is on

a _____ on the _____

(Tree, post, etc.)

(Name of road, trail, etc.)

located _____ chains E, W, N, S., from Sec. Cor.; ¼ Cor.; Witness Cor.

(Cross out nonapplicable)

Give any further facts needed to find Corner again:

USDA-FOREST SERVICE

Index File No. N-11

CORNER RECORD (SEARCH)


(Ref. FSM 7151.4)

Tract or Survey No. _____ Cor. No. _____

T 65 R. 30E R.D. _____ County _____

Merid. _____ N.F. _____ State OREGON

CORNER DIAGRAM

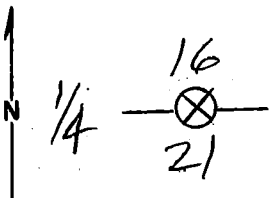

DESCRIBE CORNER MONUMENT FOUND

PINE POST - NO MARKS

DESCRIBE BEARING TREES OR OTHER OFFICIAL ACCESSORIES FOUND

28" POWDEROSA PINE w/ SCRIBES VISIBLE

PHOTO IDENTIFICATION DATA

Photo No. _____
Filed At. _____
Object Ident. _____
Ident. By _____
Signature

PLANE COORDINATE POSITION DATA

State _____ Zone _____
X _____
Y _____
Estab. By _____
Agency

Signature AIG. DARD

Title Forester Division _____

Headquarters _____ Date 4/16/52

FS-7100-52 (3/68)

CORNER RECORD (PERPETUATION)

MONUMENT: DESCRIBE NEW MONUMENT SET, OR WORK DONE TO PRESERVE EXISTING MONUMENT

9

ACCESSORIES : DESCRIBE NEW BT's WITNESS OBJECTS ETC. ESTABLISHED, OR WORK DONE TO PRESERVE EXISTING EVIDENCE

10

Work Done By _____ Title _____ Date _____ State Registration No. or Agency _____

Certified Cor. Record Prepared ? Yes No Filed At: _____ Date _____

11

REMARKS

12

Index File No. T. R. M. Tract or Surv. No. Cor. _____

13