


2-17

History of original corner establishment:

Original survey by Meldrum and Campbell
Contract No. 380, 1881.

Set a basalt stone 22x10x6 inches in a mound of
stone for corner to Secs. 2, 3, 34 and 35, from which

A Pine 9 in. dia. bears N 51°E 14 lks. dist.

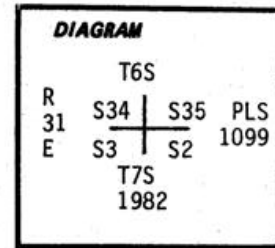

Description of corner evidence found:

The probable original monument, a basalt stone 24"x12"x6" with 4 grooves on a face and 6 grooves on an edge, lying loose, approx. 10 ft. NW of corner point.

And the only original Bearing Tree, a 14" Ponderosa Pine, alive and in good condition, with scribing visible on a previously opened blaze.

Description of monument and accessories established to perpetuate the original location of this corner:

At the True Corner Point established by record measurement to the original Bearing Tree, we set a 2"x30" Galvanized Iron Pipe 24" in the ground on a NW slope (buried cornerstone along west side) with brass cap attached, marked:

From which:

The only orig. BT, a 14" P. Pine bears N51°E 9.2 ft.,

And new BT's:

A 12" Douglas Fir, scribed "T6S R31E S34 BT" on a double blaze bears N80½°W 34.3 ft.

An 8" Douglas Fir, scribed "T6S R31E S35 BT" on a double blaze bears N63½°E 59.1 ft.

A 6" Douglas Fir, scribed "T7S R31E S2 BT" on a double blaze bears S21°E 31.6 ft.

And an 8" Douglas Fir, scribed "T7S R31E S3 BT" on a double blaze bears S39°W 22.7 ft.


Attached brass washer, marked "LS 1099" to lower blaze of new BT's.

Marked and signed BT's per BLM Manual, 1973 and USFS Standard Specifications for Cadastral Survey, Region 6, October, 1979.

Staff Compass and Steel Tape. Witnesses: Gary Langlitz
Declination = 19° East Greg Orton

July 28, 1982

Jeff Anderson

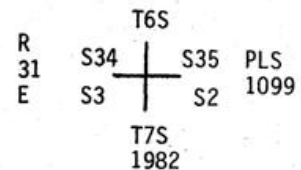

Office of Surveyor County of Umatilla
State of Oregon, I hereby certify that the within instrument was filed in this office
for record on the 10 day of January, 1983
David H. Kloes by _____
(COUNTY OFFICIAL) (DEPUTY)

Form R6-7100-57 (9/71)

RECEIVED BY
Umatilla County Surveyor
Date _____
Rec'd by _____
No. 83-03-B