

Index File No. Z-3

**CORNER RECORD (SEARCH)**

(Ref. FSM 7151.4)

Tract or Survey No. Z 3

Cor. No. 1/4

T 6 S R. 31 E

R.D. Dale


County Umatilla

Merid. Willamette

N.F. Umatilla

State Oregon

**CORNER DIAGRAM**

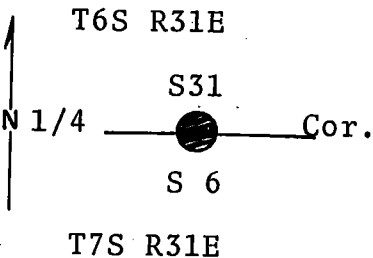

**DESCRIBE CORNER MONUMENT FOUND**

Set brass cap summer 1972. See reverse side.

**DESCRIBE BEARING TREES OR OTHER OFFICIAL ACCESSORIES FOUND**

Found 24" pine, live in ~~good~~ condition, with healed-over blazes, bearing N38°W 29.7 ft. from the corner position.

Found 36" pine, live, in good condition with scribing visible, bearing S45°W 27.7 ft. from the corner position.

**PHOTO IDENTIFICATION DATA**

Photo No. \_\_\_\_\_  
 Filed At. \_\_\_\_\_  
 Object Ident. \_\_\_\_\_  
 Ident. By \_\_\_\_\_  
*Signature*

**DESCRIBE CORNER LOCATION RELATIVE TO NEAR-BY FEATURES, ALSO HOW TO REACH CORNER**

**PLANE COORDINATE POSITION DATA**

State \_\_\_\_\_ Zone \_\_\_\_\_  
 X \_\_\_\_\_  
 Y \_\_\_\_\_  
 Etab. By \_\_\_\_\_  
*Agency*

Signature

Title

Division

Headquarters

Date

7100-52 (3/68)

4

5

CORNER RECORD (PERPETUATION)

MONUMENT: DESCRIBE NEW MONUMENT SET, OR WORK DONE TO PRESERVE EXISTING MONUMENT

Set a 30x2½" iron pipe with brass cap marked as shown, 26" in the ground and placed a mound of stone around the pipe for the 1/4 corner between secs. 31 and 6.

Set a steel fence post approx. 5 ft. West from corner with "Attention" sign attached.

ACCESSORIES : DESCRIBE NEW BT'S WITNESS OBJECTS ETC. ESTABLISHED, OR WORK DONE TO PRESERVE EXISTING EVIDENCE  
Used steel tape and magnetic compass with declination = 20° E.

Work Done By B.M. Ferguson Title Land Surveyor Date 7/12/68 State Registration No. 848  
or Agency  
Certified Cor. Record Prepared ? Yes No Filed At: Umatilla Co. Courthouse Date 11/16/72

REMARKS

Index File No. Z-3 T.

R.

M.

Tract or Surv. No.

Cor.

12  
13

USDA-FOREST SERVICE

Index

File No.

2-3

CORNER RECORD (SEARCH)

(Ref. FSM 7151.4)

Tract or

Survey No.

SEC 31

Cor.

No. S 1/4 COR

T 6S

R. 31E

R.D. DALE

County UMATILLA / GRANT CO. LINE


Merid. WILLAMETTE

N.F. UMATILLA

State OREGON

CORNER DIAGRAM

R 31 E

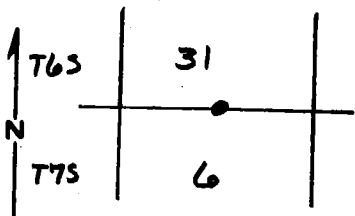

DESCRIBE CORNER MONUMENT FOUND

FIR POST (ORIG. NOTES)

10" PINE N 38° W 45 LKS ←

34" PINE S 40° W 40 LKS

DESCRIBE BEARING TREES OR OTHER OFFICIAL ACCESSORIES FOUND

SEE OTHER SIDE →

RAN EAST FROM NW CORNER. FOUND BOTH ORIGINAL BEARING TREES :

24" PINE, LIVE, IN GOOD CONDITION, WITH HEALD OVER **DAE** BLAZES, BRG N 38° W 29.7 FT FROM CORNER POSITION

36" PINE, LIVE, IN GOOD CONDITION WITH SCRIBING VISIBLE, BRG S 45° W 27.7 FT FROM CORNER POSITION

DESCRIBE CORNER LOCATION RELATIVE TO NEAR-BY FEATURES, ALSO HOW TO REACH CORNER

PHOTO IDENTIFICATION DATA

Photo No. \_\_\_\_\_

Filed At. \_\_\_\_\_

Object Ident. \_\_\_\_\_

Ident. By \_\_\_\_\_

Signature

PLANE COORDINATE POSITION DATA

State \_\_\_\_\_ Zone \_\_\_\_\_

X \_\_\_\_\_

Y \_\_\_\_\_

Estab. By \_\_\_\_\_

Agency

Signature

WOLFORD, SR.

Title

ENG. TECH

Division

Headquarters

Date

5-23-69

7100-52 (3. 68)

CORNER RECORD (PERPETUATION)

MONUMENT: DESCRIBE NEW MONUMENT SET, OR WORK DONE TO PRESERVE EXISTING MONUMENT

\* SET 30" X 2 1/2" IRON PIPE WITH BRASS CAP MARKED AS SHOWN →  
26" IN THE GROUND AND PLACED A MOUND OF STONE AROUND  
PIPE FOR THE 1/4 CORNER BETWEEN SECS. 31 & 6

T6S R31E  
1/4 S31  
S6  
T7S  
1972  
PLS 848

ACCESSORIES : DESCRIBE NEW BT<sup>1/2</sup> WITNESS OBJECTS ETC. ESTABLISHED, OR WORK DONE TO PRESERVE EXISTING EVIDENCE  
SET STEEL FENCE POST APPROX. 5 FT WEST FROM CORNER WITH "ATTENTION" SIGN  
ATTACHED

Work Done By D.M. FERGUSON Title PLS Date 1972 State Registration No. PLS 848  
or Agency

Certified Cor. Record Prepared? Yes  No  Filed At: \_\_\_\_\_ Date \_\_\_\_\_

REMARKS

DATA TRANSFERRED FROM ORIGINAL FILE CARD ON 1-19-83

\* INFO COPIED FROM "LAND CORNER MONUMENTATION" FILE.

Index File No. 2-3 T. 6S R. 31E M. WILLAMETTE Tract or Surv. No.

SEC 31 Cor. 5 1/4 COR. <sup>13</sup>