

USDA-FOREST SERVICE

Index

File No. 2-6

CORNER RECORD (SEARCH)

(Ref. FSM 7151.4)

Tract or

Survey No. SEC 32

Cor.

No. 3-W 1/16

T 6S R. 31E

R.D. DALE


County GRANT/UMATILLA CO. LINE

Merid. WILLAMETTE

N.F. UMATILLA

State OREGON

CORNER DIAGRAM

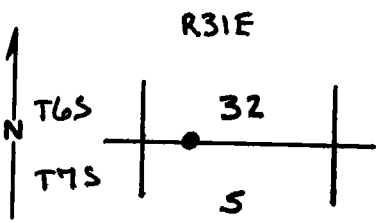

DESCRIBE CORNER MONUMENT FOUND

NO EVIDENCE FOUND

DESCRIBE BEARING TREES OR OTHER OFFICIAL ACCESSORIES FOUND

NO EVIDENCE FOUND

W 1/16 CORNER

PHOTO IDENTIFICATION DATA

Photo No. _____

Filed At. _____

Object Ident. _____

Ident. By _____

Signature

DESCRIBE CORNER LOCATION RELATIVE TO NEAR-BY FEATURES, ALSO HOW TO REACH CORNER

E-W FENCE IS 53' NORTH OF MONUMENT

PLANE COORDINATE POSITION DATA

State _____ Zone _____

X _____

Y _____

Estab. By _____

Agency

Signature

G.L. LANGLITZ

Title

PLS

Division

Headquarters

Date

12-18-82

7100-52-(3/68)

5

CORNER RECORD (PERPETUATION)

MONUMENT: DESCRIBE NEW MONUMENT SET, OR WORK DONE TO PRESERVE EXISTING MONUMENT DETERMINED CORNER POINT BY SURVEY; SET A 2" X 30" GALVANIZED IRON PIPE 20" IN THE GROUND AND SUPPORTED IN A MOUND OF STONE 4' BASE TO TOP OF PIPE, WITH BRASS CAP ATTACHED, MARKED: →

T65
 S32
 W 1/16 S5 R
 T75 31 E
 PLS 1099
 1982

ACCESSORIES: DESCRIBE NEW B^Y'S WITNESS OBJECTS ETC. ESTABLISHED, OR WORK DONE TO PRESERVE EXISTING EVIDENCE FROM WHICH WE MARK THE FOLLOWING BEARING OBJECTS

- AN "X 80" CHISELED 8" ABOVE GROUND ON A VERTICAL ROCK FACE (5' HIGH X 12' LONG, BEARS N 58 1/2° E 11.95 FT.)
- AN "X 30" CHISELED 6" ABOVE GROUND ON A VERTICAL BEDROCK FACE (3' HIGH X 3' WIDE) BEARS S 27° E 33.05 FT.)

Work Done By GARY LANGLITZ Title LAND SURVEYOR Date 8-27-82 State Registration No. LS 1099
 or Agency

Certified Cor. Record Prepared? Yes No Filed At: GRANT AND UMATILLA COUNTY Date 12-82

MAGNETIC COMPASS (DPL. 18 1/2° E)
 STEEL TAPE

REMARKS WITNESSES: GARY LANGLITZ
GREG ORTON
JEFF ANDERSON

Index File No. 2-6 T. 6S R. 31E M. WILL Tract or Surv. No. SEC 32 Cor. S-W 1/16