

Index
File No. E-11

CORNER RECORD (SEARCH)

(Ref. FSM 7151.4)

Tract or Survey No. _____
Cor. No. E-11


T 6S R. 32E

R.D. Ukiah County Umatilla

Merid. Willamette

N.F. Umatilla State Oregon

CORNER DIAGRAM

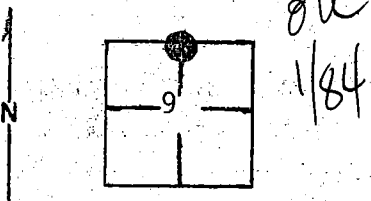

DESCRIBE CORNER MONUMENT FOUND

Brass Cap.

~~See T6S R32E E-11 Monumentation files.~~

Erected a steel post with two metal tags attached
(Attention Signs)

DESCRIBE BEARING TREES OR OTHER OFFICIAL ACCESSORIES FOUND

The new bearing trees: P 13" DBH bears S 40° W 13½ lks from corner (brass cap), painted a 6" red band and attached proper signs. Scribing new and good on both trees. P 10" DBH bears N 55 3/4° W 79½ lks. Painted a 6" band around tree and attached proper signs (Info taken from tags on trees).

PHOTO IDENTIFICATION DATA

Photo No. _____

Filed At. _____

Object Ident. _____

Ident. By _____

Signature

PLANE COORDINATE POSITION DATA

State _____ Zone _____

X _____

Y _____

Estab. By _____

Agency

Signature
Pam Moss

Title _____
Division
USFS

Headquarters
Ukiah

Date
6/18/75

7100-52 (3/68)

CORNER RECORD (PERPETUATION)

MONUMENT: DESCRIBE NEW MONUMENT SET, OR WORK DONE TO PRESERVE EXISTING MONUMENT

ACCESSORIES : DESCRIBE NEW BT'S WITNESS OBJECTS ETC. ESTABLISHED, OR WORK DONE TO PRESERVE EXISTING EVIDENCE

Work Done By _____ Title _____ Date _____ State Registration No. _____
or Agency _____

Certified Cor. Record Prepared ? Yes No Filed At _____ Date _____

REMARKS

Index File No. T. R. M. Tract or Surv. No. Cor.