


Index File No. - E-13
T 6S R. 32E
Merid. Willamette

CORNER RECORD (SEARCH)

Tract or Survey No. _____
Cor. No. E-13
R.D. Ukiah County Umatilla
N.F. Umatilla State Oregon

CORNER DIAGRAM

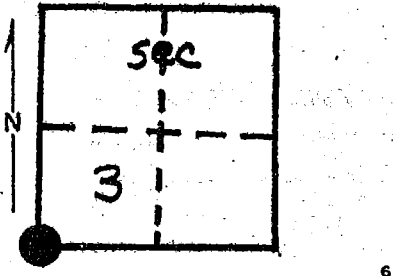

DESCRIBE CORNER MONUMENT FOUND
8/1/84
Brass Capped. This corner doesn't fit original notes. Put a post about 3' from cap and attached two metal attention signs.

PHOTO IDENTIFICATION DATA

Photo No. _____
Filed At. _____
Object Ident. _____
Ident. By _____
Signature

DESCRIBE BEARING TREES OR OTHER OFFICIAL ACCESSORIES FOUND
P 26" DBH, bears N.28° E from brass cap 16" Dist., painted 6" red band & tagged. Scribing good. P 26" DBH bears N 10° W from brass cap 7' Dist., painted 6" red band & tagged. Scribing good. These two are original trees. P 11" DBH bears S 30° W from cap, 27½ dist., painted red band & tagged. Pine 21" DBH bears S 34° N approx. 39' dist., painted red band & tagged. These two are new bearing trees.

PLANE COORDINATE POSITION DATA

State _____ Zone _____
X _____
Y _____
Etab. By _____
Agency

DESCRIBE CORNER LOCATION RELATIVE TO NEAR-BY FEATURES, ALSO HOW TO REACH CORNER

Signature Title Division Headquarters Date
Pam Moss M.L. Christian USFS UKIAH 4/30/76
7100-52
REV. 65 5

CORNER RECORD (PERPETUATION)

MONUMENT : DESCRIBE NEW MONUMENT SET, OR WORK DONE TO PRESERVE EXISTING MONUMENT

ACCESSORIES : DESCRIBE NEW BT'S WITNESS OBJECTS ETC. ESTABLISHED, OR WORK DONE TO PRESERVE EXISTING EVIDENCE

Work Done By _____ Title _____ Date _____ State Registration No. or Agency _____

Certified Cor. Record Prepared ? Yes No Filed At _____ Date _____

REMARKS

Index File No. T. R. M. Tract or Surv. No. Cor. _____