

Index
File No. K-17

CORNER RECORD (SEARCH)

(Ref. FSM 7151.4)

Tract or Survey No. _____
Cor. No. _____

T 6 S. R. 32 E.

R.D. UKIAH


County Umatilla

Merid. Will.

N.F. Umatilla

State ORE.

CORNER DIAGRAM

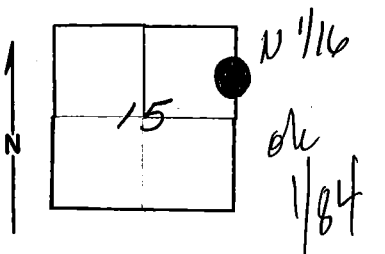

DESCRIBE CORNER MONUMENT FOUND

BRASS CAP

2

DESCRIBE BEARING TREES OR OTHER OFFICIAL ACCESSORIES FOUND

6

PHOTO IDENTIFICATION DATA

Photo No. EXR-4-228

Filed At. UKIAH

Object Ident. _____

Ident. By William CAREL
Signature

7

DESCRIBE CORNER LOCATION RELATIVE TO NEAR-BY FEATURES, ALSO HOW TO REACH CORNER

3

PLANE COORDINATE POSITION DATA

State _____ Zone _____

X _____

Y _____

Estab. By _____
Agency

8

Signature

William CAREL

Title

Division

Headquarters

UKIAH

Date

4-20-73

7100-52-(3/68)

4

5

CORNER RECORD (PERPETUATION)

MONUMENT: DESCRIBE NEW MONUMENT SET, OR WORK DONE TO PRESERVE EXISTING MONUMENT

ACCESSORIES: DESCRIBE NEW 'BT's WITNESS OBJECTS ETC. ESTABLISHED, OR WORK DONE TO PRESERVE EXISTING EVIDENCE

Work Done By _____ Title _____ Date _____ State Registration No. or Agency _____

Certified Cor. Record Prepared? Yes No Filed At: _____ Date _____

REMARKS

Index File No. *K-17T* R. M. Tract or Surv. No. Cor.