

Index  
File No. E-5  
T 6 S R. 33 E  
Merid. WILLAMETTE

CORNER RECORD (SEARCH)

(Ref. FSM 7.151.4)

Tract or  
Survey No. \_\_\_\_\_  
Cor.  
No. \_\_\_\_\_

R.D. UKIAH County UMATILLA  
N.F. UMATILLA State OREGON

CORNER DIAGRAM

T 6 S R 33 E  
S 6 | S 5  
S 7 | S 8  
1977



DESCRIBE CORNER MONUMENT FOUND

Found an iron pipe, firmly set,  
2½ ins. diam., with brass cap  
mkd.

U.S. Dept. of Interior  
Bureau of Land Management

T 6 S R 33 E  
S 6 | S 5  
S 7 | S 8  
1977

DESCRIBE BEARING TREES OR OTHER OFFICIAL ACCESSORIES FOUND

A Grand Fir, 8 ins. diam., bears N. 53½° E., 37 lks. dist.,  
A Pine, 20 ins. diam., bears S. 71° W., 51 lks. dist.,  
A Grand Fir, 12 ins. diam., bears N. 53° W., 50 lks. dist.,  
A Fir, 27 ins. diam., bears S. 24° E., 44 lks. dist., with  
fragmentary scribe marks visible on open blaze.

PHOTO IDENTIFICATION DATA

Photo No. 280-231  
Filed At. UMATILLA NAT. FOR.  
Object Ident. Direct.  
Ident. By S. Jambert  
*signature*

DESCRIBE CORNER LOCATION RELATIVE TO NEAR-BY FEATURES, ALSO HOW TO REACH CORNER

PLANE COORDINATE POSITION DATA

State \_\_\_\_\_ Zone \_\_\_\_\_  
X \_\_\_\_\_  
Y \_\_\_\_\_  
Estab. By \_\_\_\_\_

S. Jambert *signature* Agency \_\_\_\_\_

Title LS 1099 Division \_\_\_\_\_ Headquarters \_\_\_\_\_

Date 9-17-84

CORNER RECORD (PERPETUATION)

MONUMENT: DESCRIBE NEW MONUMENT SET, OR WORK DONE TO PRESERVE EXISTING MONUMENT

None

ACCESSORIES: DESCRIBE NEW BT'S, WITNESS OBJECTS, ETC. ESTABLISHED, OR WORK DONE TO PRESERVE EXISTING EVIDENCE

None

Work Done By: Gary Langlitz Title: LS 1099 Date: 8-84 State Registration No. or Agency: \_\_\_\_\_  
Certified Cor. Record Prepared? Yes  No  Filed At: \_\_\_\_\_ Date: \_\_\_\_\_

REMARKS

Index File No. E-5 T. 6S R. 33E M: WILLAMETTE Tract or Surv. No. \_\_\_\_\_ Cor. \_\_\_\_\_

Index File No. E-5

CORNER RECORD (SEARCH)

Tract or Survey No. \_\_\_\_\_  
Cor. No. E-5 <sup>24</sup> 4


T 6S R. 33E

R.D. Ukiah County Umatilla

Merid. Willamette

N.F. Umatilla State Oregon

CORNER DIAGRAM

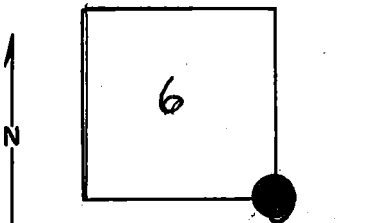

~~DESCRIBE CORNER MONUMENT FOUND~~ *Original notes*

Corner is a basalt stone 12x8x7" in ground, 5 notches on S. and E. edges, from which a:

- 1. pine 8" N58E, 32 lks
- Brass Cap:* 2. fir 24" S24E, 44 lks
- 3. fir 24" S30W, 34 lks
- See Mon. File.* 4. fir 24" S48W, 56 lks

DESCRIBE BEARING TREES OR OTHER OFFICIAL ACCESSORIES FOUND

Sec. 8 BT 12" white fir, vigorous, painted red stripe around tree.  
No evidence of Sec. 5 BT found  
Sec. 6&7 BTs missing, tree stumps and holes evident where trees were supposed to be.

PHOTO IDENTIFICATION DATA

Photo No. \_\_\_\_\_  
Filed At. \_\_\_\_\_  
Object Ident. \_\_\_\_\_  
Ident. By \_\_\_\_\_  
*Signature*

DESCRIBE CORNER LOCATION RELATIVE TO NEAR-BY FEATURES, ALSO HOW TO REACH CORNER

PLANE COORDINATE POSITION DATA

State \_\_\_\_\_ Zone \_\_\_\_\_  
X \_\_\_\_\_  
Y \_\_\_\_\_  
Estab. By \_\_\_\_\_  
*Agency*

Signature 1st Kenneth Johnson Title Forester Division \_\_\_\_\_ Headquarters \_\_\_\_\_ Date 7-22-60 <sup>4</sup>  
7100-52  
REV. 65 5

CORNER RECORD (PERPETUATION)

MONUMENT: DESCRIBE NEW MONUMENT SET, OR WORK DONE TO PRESERVE EXISTING MONUMENT

ACCESSORIES DESCRIBE NEW BT'S WITNESS OBJECTS ETC. ESTABLISHED, OR WORK DONE TO PRESERVE EXISTING EVIDENCE

Work Done By \_\_\_\_\_ Title \_\_\_\_\_ Date \_\_\_\_\_ State Registration No. or Agency \_\_\_\_\_

Certified Cor. Record Prepared ? Yes No Filed At: \_\_\_\_\_ Date \_\_\_\_\_

REMARKS

Index File No. E-5 T. R. M. Tract or Surv. No. Cor. \_\_\_\_\_