

USDA-FOREST SERVICE

Index File No. X-25

CORNER RECORD (SEARCH)

(Ref. FSM 7151.4)

Tract or Survey No. \_\_\_\_\_ Cor. No. \_\_\_\_\_


T 65 R. ~~32E~~ 33E

R.D. NORTH FORK JOHN DAY County UMATILLA

Merid. WILLAMETTE

N.F. UMATILLA State OREGON

CORNER DIAGRAM

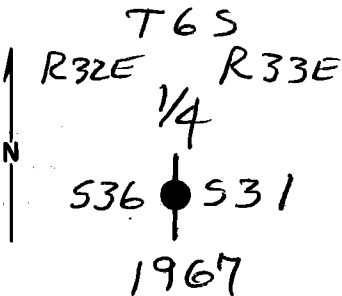

DESCRIBE CORNER MONUMENT FOUND

BLM BRASS CAPPED IRON PIPE.  
CAP MKD AS IN DIAGRAM.

DESCRIBE BEARING TREES OR OTHER OFFICIAL ACCESSORIES FOUND

BT'S OF RECORD ARE OK.

PHOTO IDENTIFICATION DATA

Photo No. \_\_\_\_\_  
Filed At. \_\_\_\_\_  
Object Ident. \_\_\_\_\_  
Ident. By \_\_\_\_\_  
*Signature*

DESCRIBE CORNER LOCATION RELATIVE TO NEAR-BY FEATURES, ALSO HOW TO REACH CORNER

PLANE COORDINATE POSITION DATA

State \_\_\_\_\_ Zone \_\_\_\_\_  
X \_\_\_\_\_  
Y \_\_\_\_\_  
Estab. By \_\_\_\_\_  
*Agency*

Signature \_\_\_\_\_ Title \_\_\_\_\_ Division \_\_\_\_\_ Headquarters \_\_\_\_\_ Date \_\_\_\_\_ FS-7100-52 (3/68)

*Dennis L. Layland* PLS 1636 MARCH 1997

**CORNER RECORD (PERPETUATION)**

**MONUMENT : DESCRIBE NEW MONUMENT SET, OR WORK DONE TO PRESERVE EXISTING MONUMENT**

**ACCESSORIES : DESCRIBE NEW BT'S WITNESS OBJECTS ETC. ESTABLISHED, OR WORK DONE TO PRESERVE EXISTING EVIDENCE**

Work Done By \_\_\_\_\_ Title \_\_\_\_\_ Date \_\_\_\_\_ State Registration No. or Agency \_\_\_\_\_

Certified Cor. Record Prepared ? Yes No Filed At \_\_\_\_\_ Date \_\_\_\_\_

**REMARKS**

Index File No. T. R. M. Tract or Surv. No. Cor.

USDA-FOREST SERVICE

Index

File No. X-25

T65

R32E

Merid. Willamette

R.D.

N.F.

CORNER RECORD (SEARCH)

Ref. FSM 7151.4

North Fork John Day

Umatilla

Tract or

Survey No

County Umatilla

State Oregon

Cor.

No.

x ----- 1

Corner Diagram

114  
S36 | S31  
R32E | R33E  
1967

1 Describe corner monument found  
1 Standard BLM brass cap stamped as shown in the corner diagram.

x ----- 1 ----- x

Photo Identification Data

Photo No. 1687-76  
filed at Pendleton, OR  
Object Ident. Bearing Trees  
Ident. by David L. Haddock  
Signature

1 Describe bearing trees or other official accessories found  
1 A 18" Ponderosa Pine bears N37 E, 42.2'.  
1 A 19" Ponderosa Pine bears N30 W, '  
1 A 40" Ponderosa Pine snag bears S37 W, 71.3'.

x ----- 1 ----- x

Plane Coordinate Position Data

State Zone  
X  
Y  
Estab. by  
Agency

1 Describe corner location relative to near-by features, also how to reach corner  
1 From the junction of roads 55 and 5507, follow road 5507 3.1 miles east to road  
1 096. Follow this road 0.2 miles north to road 221. Follow road 221 0.1 miles  
1 east to a point where the corner is plainly visible about 200' to the south.

x ----- 1 ----- x

Signature	Title	Division	Headquarters	Date	7100.52
David L. Haddock	Land Surveyor		Pendleton, OR	July 1988	

CORNER RECORD (PERPETUATION)

X \_\_\_\_\_ X  
 Monument: Describe new monument set, or work done to preserve existing monument

Set steel guard post 5" west of the monument and attached Forest Service Land Survey Monument and Property Boundary signs.

X \_\_\_\_\_ X  
 Accessories: Describe new BT's witness objects etc. established, or work done to preserve existing evidence

Made bands around trees and painted bands and scribe blazes red. Attached Forest Service Land Survey Monument and Bearing Tree signs to the trees.

X \_\_\_\_\_ X

Work done by	David L. Haddock	Title	Land Surveyor	Date	July 1988	State Registration No.	
Certified cor. record prepared?	yes		no x	Filed at		or Agency	852
						Date	

X \_\_\_\_\_ X

REMARKS

X \_\_\_\_\_ X

Index File No. X-25 T.6S. R.32E. M. Willamette Tract or Survey No. Cor.