


CERTIFIED RECORD OF LAND CORNER MONUMENTATION

y-1

History of original corner establishment:

Unsurveyed - subdivided section.

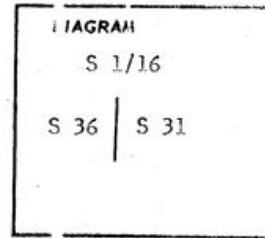

No record of subsequent remonumentation found in County Records.

Description of corner evidence found:

None.

Description of monument and accessories established to perpetuate the original location of this corner

Set 2 1/2" x 30" iron pipe 26" in ground with brass cap marked as shown from which I scribed bearing trees:


A tamarack 33 in. diameter bears N 10° 29' W 85.60 ft. marked S 1/16 S 36 T 6S R 32E BT  
A pine 29 in. diameter bears S 50° 47' E 18.2 ft. marked S 1/16 S 31 T 6S R 33E BT

Nailed a brass washer marked PLS 933 to the BT blaze of all trees. Set steel post 3 ft. East of corner. Corner is 20 ft. East of road which runs North by South. Used T-2 and steel tape, measuring a horizontal distance to the center of bearing trees.

REGISTERED PROFESSIONAL LAND SURVEYOR

David H. Krumbein

OREGON JULY 17, 1970 DAVID H. KRUMBEIN 933

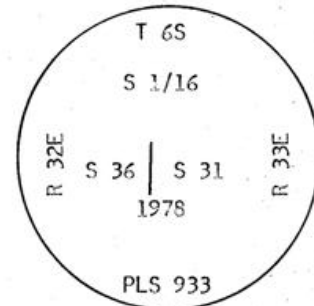

Office of ..... County Surveyor ..... County of Umatilla  
State of Oregon, I hereby certify that the within instrument was filed in this office for record on the ..... day of .....  
..... by .....  
(COUNTY OFFICIAL) (DEPUTY)

Q-913