

Index File No. E-25

CORNER RECORD (SEARCH)

Tract or Survey No. _____ Cor. No. _____


T. 6 S. R. 33 E.

R.D. UKIAH County Umatilla

Merid. will.

N.F. Umatilla State ORE.

CORNER DIAGRAM

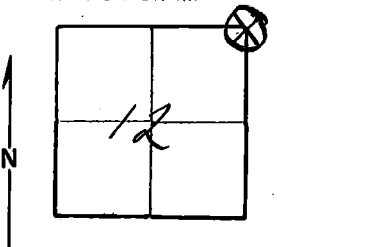

DESCRIBE CORNER MONUMENT FOUND

DESCRIBE BEARING TREES OR OTHER OFFICIAL ACCESSORIES FOUND

29" D.B.H. brs. N.22°E. 28 lks. - dead
 18" D.B.H. brs. S. 41°W. 15 lks. - dead
 10" Lodge pole brs. N.65°W. 11 lks. - dead & down

PHOTO IDENTIFICATION DATA

Photo No. _____
 Filed At. _____
 Object Ident. _____
 Ident. By _____

Signature

PLANE COORDINATE POSITION DATA

State _____ Zone _____
 X _____
 Y _____
 Estab. By _____
 Agency _____

DESCRIBE CORNER LOCATION RELATIVE TO NEAR-BY FEATURES, ALSO HOW TO REACH CORNER

Signature

Title

Division

Headquarters

Date

Melvin Christian

Forestry Tech.

UKIAH

5-4-71

7100-52

REV. '65 5

CORNER RECORD (PERPETUATION)

MONUMENT: DESCRIBE NEW MONUMENT SET, OR WORK DONE TO PRESERVE EXISTING MONUMENT

ACCESSORIES DESCRIBE NEW BT'S WITNESS OBJECTS ETC. ESTABLISHED, OR WORK DONE TO PRESERVE EXISTING EVIDENCE

Work Done By _____ Title _____ Date _____ State Registration No. or Agency _____
Certified Cor. Record Prepared ? Yes No Filed At: _____ Date _____

REMARKS

Index File No. *E-25.T.* R. M. Tract or Surv. No. Cor. _____