

T. 6 S. R. 34 E.
Merid. Willamette

R.D. North Fork John Day
N.F. Umatilla

County Umatilla
State Oregon

CORNER DIAGRAM



DESCRIBE CORNER MONUMENT FOUND

Found a 1 1/2" aluminum cap, projecting 1" out of the ground.

DESCRIBE BEARING TREES OR OTHER OFFICIAL ACCESSORIES FOUND

16" Western Larch Snag, N. 14 1/2 E., 15.2 feet, with scribing visible on burnt double blaze.
8" Western Larch, S. 78 1/2 W., 52.1 feet, with burnt out double blaze.

PHOTO IDENTIFICATION DATA

Photo No.
Filed At.
Object Ident.
Ident. By

Signature

DESCRIBE CORNER LOCATION RELATIVE TO NEAR-BY FEATURES, ALSO HOW TO REACH CORNER

The corner is located on a high point on the ridge between North Fork Cable creek and Winom creek.

PLANE COORDINATE POSITION DATA

State: Zone:
X:
Y:
Datum:

Signature

D. Schlaich

Title

Land Surveyor

Division

Headquarters

S.O.

Date

10/31/1997

FS-7100-52 (3/97)

CORNER RECORD (PERPETUATION)

MONUMENT: DESCRIBE NEW MONUMENT SET, OR WORK DONE TO PRESERVE EXISTING MONUMENT

ACCESSORIES: DESCRIBE NEW BT'S WITNESS OBJECTS ETC. ESTABLISHED, OR WORK DONE TO PRESERVE EXISTING EVIDENCE

22" Western Larch, S. 62 E., 116.2 feet, scribed "WB/651" "BT" on double blaze.

9" Western Larch, S. 47 W., 61.5 feet, scribed "WB/651" "BT" on double blaze.

Work Done By D. Schlaich Title Land Surveyor Date 10/31/1997 State Registration No. _____
or Agency _____
Certified Corner Record Prepared? Yes No Filed At: _____ Date _____

REMARKS

USDA-FOREST SERVICE

Index
File No.

T. 6 S. R. 34 E.
Merid. WILAMETTE


CORNER RECORD (SEARCH)
(Ref. FSM 7151.4)

R.D. NFJD County UMATILLA
N.F. UMATILLA State OREGON

Tract or
Survey No. Tower Unit

Cor.
No. AP-651

CORNER DIAGRAM

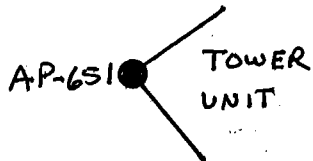

DESCRIBE CORNER MONUMENT FOUND

5/8" rebar, with a 1 1/2" aluminum cap, projecting 1" out of the ground, marked "USDA-FS WB 651 1991 LS 1636".

DESCRIBE BEARING TREES OR OTHER OFFICIAL ACCESSORIES FOUND

8" Western Larch, S. 79° W., 51.7 ft., mkd. "WB/651""BT" on double blaze.
15" Western Larch, N. 16° E., 15.2 ft., mkd. "WB/651""BT" on double blaze.
Both BT's have 3/4" brass washer mkd. "PLS 1636" nailed next to "BT" scribing.

PHOTO IDENTIFICATION DATA

Photo No.:
Filed At.:
Object Ident.:
Ident. By:

Signature

DESCRIBE CORNER RELATIVE TO NEAR-BY FEATURES, ALSO HOW TO REACH CORNER

The corner is located on a high point on the ridge between North Fork Cable Creek and Winom Creek.

PLANE COORDINATE POSITION DATA

State: Oregon Zone: North
X: 2,478,094.17'
Y: 501,653.91'
Datum: NAD1927

Signature

D. Schlaich

Title

Land Surveyor

Division

Headquarters

S.O.

Date

08-1993

FS-7100-52 (3/68)

CORNER RECORD (PERPETUATION)

MONUMENT: DESCRIBE NEW MONUMENT SET, OR WORK DONE TO PRESERVE EXISTING MONUMENT

ACCESSORIES : DESCRIBE NEW BT's WITNESS OBJECTS ETC. ESTABLISHED, OR WORK DONE TO PRESERVE EXISTING EVIDENCE

Work Done By _____ Title _____ Date _____ State Registration No. or Agency _____

Certified Cor. Record Prepared? **NO** Filed At: _____ Date _____

REMARKS

Index File No. _____ T. **6 S.** R. **34 E.** M. **W.M.** Tract or Survey No. **Tower Unit** Cor. **AP-651**