

Index

File No.

T. 6 S. R. 34 E.

Merid. WILLAMETTE

CORNER RECORD (SEARCH)

(Ref. FSM 7151.4)

R.D. NOTH FORK JOHN DAY

N.F. UMATILLA

County UMATILLA

State OREGON


Tract or

Survey No. **TOWER UNIT**

Cor.

No. **AP-458**

CORNER DIAGRAM

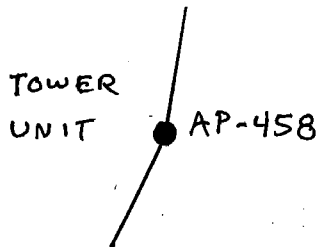

DESCRIBE CORNER MONUMENT FOUND

NONE

DESCRIBE BEARING TREES OR OTHER OFFICIAL ACCESSORIES FOUND

NONE

PHOTO IDENTIFICATION DATA

Photo No.:

Filed At.:

Object Ident.:

Ident. By:

Signature

DESCRIBE CORNER RELATIVE TO NEAR-BY FEATURES, ALSO HOW TO REACH CORNER

From the junction of road 52 and trail 3156 (Big creek) hike up the trail approx 2.1 miles to the corner which is located northwest of the trail 100 feet.

PLANE COORDINATE POSITION

State: Oregon Zone: North

X: 2,496,235.22'

Y: 500,216.89'

Datum: NAD1927

Signature

D. Schlaich

Title

Land Surveyor

Division

Headquarters

S.O.

Date

09/1995

FS-7100-52 (3/68)

CORNER RECORD (PERPETUATION)

MONUMENT: DESCRIBE NEW MONUMENT SET, OR WORK DONE TO PRESERVE EXISTING MONUMENT

Set at a point 100 feet northwesterly of and perpendicular to the centerline of trail 3156, a 5/8" by 18" rebar, with a 3 1/4" aluminum cap, set in concrete 12" in the ground, mkd. "NFJD WILDERNESS TOWER UNIT AP-458 RLS 2308 1995"

ACCESSORIES : DESCRIBE NEW BT's WITNESS OBJECTS ETC. ESTABLISHED, OR WORK DONE TO PRESERVE EXISTING EVIDENCE

12" Western Larch, S 43 1/2° E, 39.1 feet, mkd. "WB/458" "BT".

6" Lodgepole Pine, S 51° W, 19.7 feet, mkd. "WB/458" "BT".

The BT's are double blazed and have a 3/4" brass washer stamped "RLS 2308" nailed to the lower blaze by the "BT" scribing.

Work Done By D. Schlaich

Title Land Surveyor

Date 09/1995

State Registration No.
or Agency

Certified Cor. Record Prepared ? NO

Filed At:

Date

REMARKS

Index File No.

T.

6 S.

R.

34 E.

M.

W.M.

Tract or Survey No.

TOWER UNIT

Cor.

AP-458