

Index

File No. Z-23

CORNER RECORD (SEARCH)

(Ref. FSM 7151.4)

Tract or

Survey No. _____

Cor.

No. 5. 1/4


T 6 S. R. 34 E

R.D. NORTH FORK JOHN DAY County Umatilla

Merid. Willamette

N.F. Umatilla State Oregon

CORNER DIAGRAM

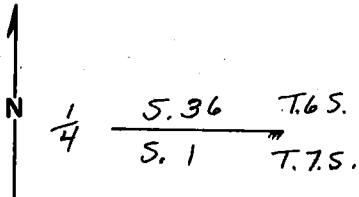

DESCRIBE CORNER MONUMENT FOUND

Post gone

DESCRIBE BEARING TREES OR OTHER OFFICIAL ACCESSORIES FOUND

- ① Down and Badly rotted tree w/scribes 1/4 SBT and 2 chain notches, S. 38° W, 70 LKS.
- ② N.E. B.T. Gone

old creek channel north 7' ±.
meadow creek, North, 50'

PHOTO IDENTIFICATION DATA

Photo No. 580-57

Filed At. BENDLETON

Object Ident. PRECISE

Ident. By _____

Signature

PLANE COORDINATE POSITION DATA

State _____ Zone _____

X _____

Y _____

Estab. By _____

Agency

DESCRIBE CORNER LOCATION RELATIVE TO NEAR-BY FEATURES, ALSO HOW TO REACH CORNER

Take Road 570 off 52 to point NORTH of Rock out cropping on South side of creek. Corner is south of you.

Signature

Title

Division

Headquarters

Date

FS-7100-52 (3/68)

Clayton J. Monte

Land Surveyor

10/25/86

2

3

4

5

CORNER RECORD (PERPETUATION)

MONUMENT: DESCRIBE NEW MONUMENT SET, OR WORK DONE TO PRESERVE EXISTING MONUMENT

Set a 2 1/2" Diam. Alum. cap on a 2 1/2" X 30" Alum. pipe w/ flare at bottom, at record bearing and distance from remaining B.T. Cap MKD. per sketch. Set steel posts 4' ± E. & W. w/ prop. Bndry., Attn. and mon. signs attached.

T65 R34E
1/4 S.36
S.1
T7S
RPLS 1910
1986

ACCESSORIES: DESCRIBE NEW BT'S WITNESS OBJECTS ETC. ESTABLISHED, OR WORK DONE TO PRESERVE EXISTING EVIDENCE

① 13" D.B.H. Lodgepole Pine, S. 87° E., 10.0', scribed 1/4 S1BT.

② 9" D.B.H. Lodgepole Pine, N. 10° E., 15.7', scribed 1/4 S36BT.

Each B.T. has a brass washer mkd. RPLS 1910 set btwn. B&T, B.T. tag, attn. sign, bands and faces painted red.

Work Done By C.J. Martin Title Land Surveyor Date 10/25/86 State Registration No. or Agency _____

Certified Cor. Record Prepared? Yes No _____ Filed At: _____ Date _____

REMARKS

Index File No. T. 65 R. 34 E M. Willamette Tract or Surv. No. Cor. S.36

Z-25 1/4 S.1
GPO: 1982 O-382-659