

T. 6 S. R. 35 E.
Merid. Willamette

R.D. North Fork John Day
N.F. Umatilla

County Umatilla
State Oregon

CORNER DIAGRAM



DESCRIBE CORNER MONUMENT FOUND

Found a 5/8" rebar with 3 1/4" aluminum cap, projecting 5" out of the ground.

DESCRIBE BEARING TREES OR OTHER OFFICIAL ACCESSORIES FOUND

21" Douglas Fir, N. 43 E., 39.0 feet, with scribing visible on double blaze.
11" Lodgepole Pine Snag, N. 19 W., 30.9 feet, with scribing visible on double blaze.

PHOTO IDENTIFICATION DATA

Photo No.
Filed At.
Object Ident.
Ident. By

Signature _____

DESCRIBE CORNER LOCATION RELATIVE TO NEAR-BY FEATURES, ALSO HOW TO REACH CORNER

From the jct. Of roads 52 and 5226 travel northerly on 5226 approx. 7.04 miles. The corner is located approx. 200 feet westerly of the road.

PLANE COORDINATE POSITION DATA

State: Zone:

X:

Y:

Datum:

Signature
D. Schlaich

Title
Land Surveyor

Division

Headquarters
S.O.

Date
10/28/1997

FS-7100-52 (3/97)

CORNER RECORD (PERPETUATION)

MONUMENT: DESCRIBE NEW MONUMENT SET, OR WORK DONE TO PRESERVE EXISTING MONUMENT

ACCESSORIES: DESCRIBE NEW BT'S WITNESS OBJECTS ETC. ESTABLISHED, OR WORK DONE TO PRESERVE EXISTING EVIDENCE

21" Douglas Fir, S. 12 1/2 E., 49.0 feet, scribed "WB/260" "BT" on double blaze.

Work Done By D. Schlaich

Title Land Surveyor

Date 10/28/1997

State Registration No.
or Agency _____

Certified Corner Record Prepared ?

Yes

No

Filed At: _____

Date _____

REMARKS

USDA-FOREST SERVICE

Index

File No.

T. 6 S. R. 35 E.

Merid. WILLAMETTE

CORNER RECORD (SEARCH)
(Ref. FSM 7151.4)

R.D. NFJD

N.F. UMATILLA


County UMATILLA

State OREGON

Tract or
Survey No. Tower Unit

Cor.
No. AP-260

CORNER DIAGRAM

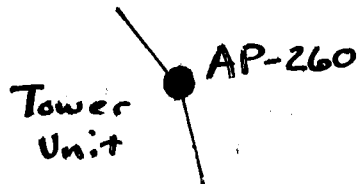

DESCRIBE CORNER MONUMENT FOUND

NONE

DESCRIBE BEARING TREES OR OTHER OFFICIAL ACCESSORIES FOUND

NONE

PHOTO IDENTIFICATION DATA

Photo No.:

Filed At.:

Object Ident.:

Ident. By:

Signature

PLANE COORDINATE POSITION DATA

State: Oregon Zone: North

X: 2,503,378.57'

Y: 510,607.37'

Datum: NAD1927

DESCRIBE CORNER RELATIVE TO NEAR-BY FEATURES, ALSO HOW TO REACH CORNER

From the jct. of FS rds. 52 and 5226 travel northerly on 5226 approx. 7.04 miles. The corner is located approx. 200 westerly of the road.

Signature

D. Schlaich

Title

Land Surveyor

Division

Headquarters

S.O.

Date

07-1993

FS-7100-52 (3/68)

CORNER RECORD (PERPETUATION)

MONUMENT: DESCRIBE NEW MONUMENT SET, OR WORK DONE TO PRESERVE EXISTING MONUMENT

5/8" by 3/8" rebar, with a 3 1/4" aluminum cap, 32" in the ground, marked "NFJD WILDERNESS TOWER UNIT AP-260 RLS2308 1993".

ACCESSORIES : DESCRIBE NEW BT's WITNESS OBJECTS ETC. ESTABLISHED, OR WORK DONE TO PRESERVE EXISTING EVIDENCE

22" Fir, N. 45° E., 39.0 ft., mkd. "WB/260""BT" on double blaze.

11" Lodgepole Pine, N. 17° W., 30.9 ft., mkd. "WB/260"BT" on double blaze.

Work Done By **D. Schlaich**

Title Land Surveyor

Date **07-1993**

State Registration No.
or Agency

Certified Cor. Record Prepared ? **NO**

Filed At:

Date

REMARKS

Index File No.

T.

6 S.

R.

35 E.

M.

W.M.

Tract or Survey No.

Cor.

AP-260