

USDA-FOREST SERVICE

Index

File No.

T. 6 S. R. 35 E.

Merid. WILLAMETTE

CORNER RECORD (SEARCH)

(Ref. FSM 7151.4)

R.D. NFJD

N.F. UMATILLA

County UMATILLA

State OREGON


Tract or

Survey No. Tower Unit

Cor.

No. AP-333

CORNER DIAGRAM

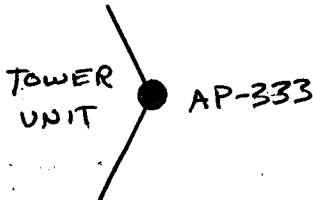

DESCRIBE CORNER MONUMENT FOUND

NONE

DESCRIBE BEARING TREES OR OTHER OFFICIAL ACCESSORIES FOUND

NONE

PHOTO IDENTIFICATION DATA

Photo No.:

Filed At.:

Object Ident.:

Ident. By:

Signature

DESCRIBE CORNER RELATIVE TO NEAR-BY FEATURES, ALSO HOW TO REACH CORNER

From the jct. of FS rds. 52 and 5226 travel northerly on 5226 approx. 5.15 miles. The corner is located approx. 200 westerly of the road.

PLANE COORDINATE POSITION DATA

State: Oregon Zone: North

X: 2,506,377.15'

Y: 504,410.03'

Datum: NAD1927

Signature

D. Schlaich

Title

Land Surveyor

Division

Headquarters

S.O.

Date

09-1993

FS-7100-52 (3/68)

CORNER RECORD (PERPETUATION)

MONUMENT: DESCRIBE NEW MONUMENT SET, OR WORK DONE TO PRESERVE EXISTING MONUMENT

5/8" by 36" rebar, with a 3 1/4" aluminum cap, 35" in the ground, marked "NFJD WILDERNESS TOWER UNIT AP-333 RLS2308 1993".

ACCESSORIES : DESCRIBE NEW BT's WITNESS OBJECTS ETC. ESTABLISHED, OR WORK DONE TO PRESERVE EXISTING EVIDENCE

21" Fir, N. 38° W., 38.6 ft., mkd. "WB/333"BT" on double blaze.

10" Lodgepole Pine, S. 27° E., 39.2 ft., mkd. "WB/333"BT" on double blaze.

Work Done By **D. Schlaich**

Title Land Surveyor

Date **06-1993**

State Registration No.
or Agency

Certified Cor. Record Prepared ? **NO**

Filed At:

Date

REMARKS

Index File No.

T.

6 S.

R.

35 E.

M.

W.M.

Tract or Survey No.

Cor.

AP-333