

Index
File No. 2-19
T 6 S. R. 32 E.
Merid. W. M.


CORNER RECORD (SEARCH)

(Ref. FSM 7151.4)

Tract or Survey No. _____ Cor. No. _____

R.D. Dale County Grant - Umatilla
N.F. Umatilla State Oregon

CORNER DIAGRAM

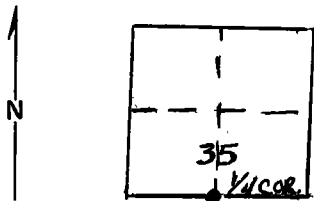

2
T75, R32 E

DESCRIBE CORNER MONUMENT FOUND

Material: _____ Size: _____
Height Above Ground: 6" Condition: Good
Markings: 1967 Brass Cap

DESCRIBE BEARING TREES OR OTHER OFFICIAL ACCESSORIES FOUND

Set Brass cap and two new bearing trees. Both Douglas Fir
The one in sec. 2 is 7" D.B.H., and the one in S. 35 is
5" D.B.H..

The corner is about a $\frac{1}{2}$ chain off the road S-747. The
old bearing tree is 26" Ponderosa Pine D.B.H. and it is
still good. There is a location tag on the upside road S-747.

PHOTO IDENTIFICATION DATA

Photo No. _____
Filed At. _____
Object Ident. _____
Ident. By _____

Signature _____

DESCRIBE CORNER LOCATION RELATIVE TO NEAR-BY FEATURES, ALSO HOW TO REACH CORNER

PLANE COORDINATE POSITION DATA

State _____ Zone _____
X _____
Y _____
Estab. By _____

Agency _____

Signature Carl Graves Title Timber Division _____ Headquarters Dale Date 3-26-73 7100-52 (3/68)

CORNER RECORD (PERPETUATION)

MONUMENT: DESCRIBE NEW MONUMENT SET, OR WORK DONE TO PRESERVE EXISTING MONUMENT

9

ACCESSORIES : DESCRIBE NEW BT'S WITNESS OBJECTS ETC. ESTABLISHED, OR WORK DONE TO PRESERVE EXISTING EVIDENCE

10

Work Done By _____ Title _____ Date _____ State Registration No. or Agency _____

Certified Cor. Record Prepared ? Yes No Filed At: _____ Date _____

11

REMARKS

12

Index File No. Z-19 T. 6S. R. 32 E. M. Sec. 35 Tract or Surv. No. _____ Cor. _____

13