

USDA-FOREST SERVICE


Index  
File No. 2-8  
T 65 R. 32E  
Merid. WILLAMETTE

CORNER RECORD (SEARCH)

(Ref. FSM 7151.4)  
R.D. North Fork JOHN DAY County UMATILLA  
N.F. UMATILLA State OR

Tract or Survey No. \_\_\_\_\_  
Cor. No. \_\_\_\_\_

CORNER DIAGRAM

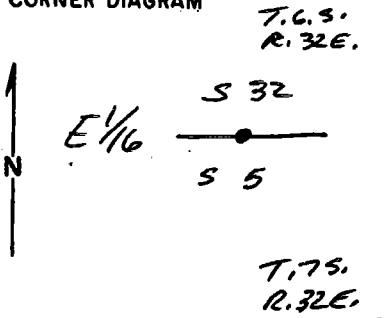

DESCRIBE CORNER MONUMENT FOUND

BRASS CAP MCD. E 1/16 S 32 SET ON IRON POST  
S 5 IN MOUND OF STONE  
1968

DESCRIBE BEARING TREES OR OTHER OFFICIAL ACCESSORIES FOUND

BT, a FIR 20" DIAM., BEARS N. 46 1/2° W., 74 lks, HEALED BLAZE  
USFS SIGNS 54-3 AND 54-9

BT, a PINE 11" DIAM., BEARS S 45 1/2° W., 48 1/2 lks, HEALED BLAZE  
USFS SIGNS 54-3 AND 54-9

2 GUARD POSTS, E. AND W. OF CORNER MONUMENT,

PHOTO IDENTIFICATION DATA

Photo No. \_\_\_\_\_  
Filed At. \_\_\_\_\_  
Object Ident. \_\_\_\_\_  
Ident. By \_\_\_\_\_  
Signature \_\_\_\_\_

DESCRIBE CORNER LOCATION RELATIVE TO NEAR-BY FEATURES, ALSO HOW TO REACH CORNER

CROSS N. FORK JOHN DAY RIVER IN SW OF SECTION 28 T. 6 S., R. 32 E.,  
FOLLOW LOGGING ROAD W. AND W. APPROX. ONE MILE. ROAD TURNS EAST, 90  
APPROX. 1000' TO USFS LOCATION POSTER ATTACHED TO 4" X 4" WOOD POST  
SET ON SOUTH SIDE OF LOGGING ROAD. FOLLOW POSTER SUB-DIVISIONAL  
LINE APPROX. 600' TO CORNER MONUMENT.

PLANE COORDINATE POSITION DATA

State \_\_\_\_\_ Zone \_\_\_\_\_  
X \_\_\_\_\_  
Y \_\_\_\_\_  
Estab. By \_\_\_\_\_  
Agency \_\_\_\_\_

Signature  
*Ken M. Co*

Title  
*John Christ*

Division

Headquarters

Date

12/90

FS-7100-52 (3/68)

CORNER RECORD (PERPETUATION)

MONUMENT : DESCRIBE NEW MONUMENT SET, OR WORK DONE TO PRESERVE EXISTING MONUMENT

CLEARED BRUSH FROM AROUND CORNER MONUMENT

9

ACCESSORIES : DESCRIBE NEW BT'S WITNESS OBJECTS ETC. ESTABLISHED, OR WORK DONE TO PRESERVE EXISTING EVIDENCE

PAINTED BT'S

10

Work Done By GUY (PAT) STAMMER Title LAND SURVEYOR Date 12/70 State Registration No. PLS 1341  
or Agency

Certified Cor. Record Prepared ? Yes  No Filed At: Date

REMARKS

WITNESS: KEN BATES

12

Index File No. Z-8 T. 6S R. 32E M. WM Tract or Surv. No. Cor.

13