


USDA-FOREST SERVICE

Index File No. C-10 N. **CORNER RECORD (SEARCH)** Tract or Survey No. _____ Cor. No. _____
 T 78 R. 32E R.D. John Day County Grant
 Merid. W.M. N.F. Umatilla State Or.

CORNER DIAGRAM

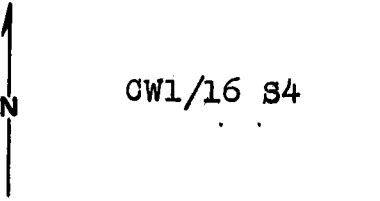

1 DESCRIBE CORNER MONUMENT FOUND

2 1/2" iron pipe with 3 1/4" brass cap (BLM) W1/16
 mkd.; C S4 C
 1982

2 DESCRIBE BEARING TREES OR OTHER OFFICIAL ACCESSORIES FOUND

P. Pine, 16", S86 1/2° E, 193 lks.; with scribing visible.
 P. Pine, 17", S86° W, 265 lks.; with scribing visible.

6 PHOTO IDENTIFICATION DATA

Photo No. _____
 Filed At. _____
 Object Ident. _____
 Ident. By _____
 Signature _____

3 DESCRIBE CORNER LOCATION RELATIVE TO NEAR-BY FEATURES, ALSO HOW TO REACH CORNER

Corner falls in open on SWly slope and is visible from rd. to N. Posted line E. and W.

7 PLANE COORDINATE POSITION DATA

State _____ Zone _____
 X _____
 Y _____
 Estab. By _____
 Agency _____

Signature *F. L. Munn*

Title PLS Division _____ Headquarters _____

Date 7/11/90 FS-7100-52 (3/68) 5

CORNER RECORD (PERPETUATION)

MONUMENT: DESCRIBE NEW MONUMENT SET, OR WORK DONE TO PRESERVE EXISTING MONUMENT

None..

9

ACCESSORIES : DESCRIBE NEW BT'S WITNESS OBJECTS ETC. ESTABLISHED, OR WORK DONE TO PRESERVE EXISTING EVIDENCE

None..

10

Work Done By. F.S. Munro Title PLS 7/4/90 State Registration No. 1832
or Agency

Certified Cor. Record Prepared ? Yes No Filed At: _____ Date _____

11

REMARKS

Index File No. C-10 T. 78 R. 32E M. W.M.. Tract or Surv. No. _____ Cor. _____

12

13