

Index
File No. Z-3


CORNER RECORD (SEARCH)
(Ref. FSM 7151.4)

Tract or
Survey No. _____ Cor. No. Z-3

T 6S R. 33E R.D. _____ County _____

Merid. _____ N.F. _____ State _____

CORNER DIAGRAM

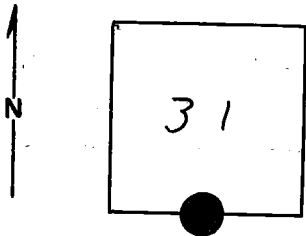

DESCRIBE CORNER MONUMENT FOUND

~~CR T7S, R33E A-3~~
Brass Cap! See Moni File

DESCRIBE BEARING TREES OR OTHER OFFICIAL ACCESSORIES FOUND

PHOTO IDENTIFICATION DATA

Photo No. _____
Filed At. _____
Object Ident. _____
Ident. By _____

Signature

DESCRIBE CORNER LOCATION RELATIVE TO NEAR-BY FEATURES, ALSO HOW TO REACH CORNER

PLANE COORDINATE POSITION DATA

State _____ Zone _____
X _____
Y _____
Estab. By _____

Agency

Signature

Title

Division

Headquarters

Date

CORNER RECORD (PERPETUATION)

MONUMENT: DESCRIBE NEW MONUMENT SET, OR WORK DONE TO PRESERVE EXISTING MONUMENT

9

ACCESSORIES : DESCRIBE NEW BT'S WITNESS OBJECTS ETC. ESTABLISHED, OR WORK DONE TO PRESERVE EXISTING EVIDENCE

10

Work Done By _____ Title _____ Date _____ State Registration No. _____
or Agency _____

Certified Cor. Record Prepared ? Yes No Filed At _____ Date _____

11

REMARKS

12

Index File No. 1 T. R. M. Tract or Surv. No. Cor. 13

U11

CORNER RECORD (SEARCH)

LL
Cor. No. A-3 ²

Index File No. A-3

Tract or Survey No. _____


T 7S R. 33E

R.D. UKiah County Umatilla

Merid. Will.

N.F. Umatilla State Oregon

CORNER DIAGRAM

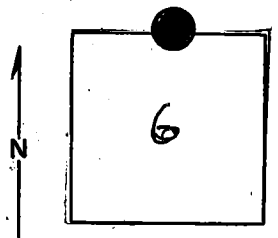

DESCRIBE CORNER MONUMENT FOUND

None
Brass Cap! 500 Mon, F. 10

DESCRIBE BEARING TREES OR OTHER OFFICIAL ACCESSORIES FOUND

36" Pine stump, Bearing N. 20° E, 43 lks.
The "B" was partially visible. Only part of blaze left.

PHOTO IDENTIFICATION DATA

Photo No. EOD; 7-160 (9/1/66)

Filed At. _____

Object Ident. None

Ident. By _____
Signature

DESCRIBE CORNER LOCATION RELATIVE TO NEAR-BY FEATURES, ALSO HOW TO REACH CORNER

Corner found by proceeding E. from location poster on road.

PLANE COORDINATE POSITION DATA

State _____ Zone _____

X _____

Y _____

Etab. By _____
Agency

Signature _____

Title
Eng. Aide

Division
USFS

Headquarters
Umatilla-S.O.

Date
7/23/69

7100-52
REV. 65 5

CORNER RECORD (PERPETUATION)

MONUMENT: DESCRIBE NEW MONUMENT SET, OR WORK DONE TO PRESERVE EXISTING MONUMENT

Drove a round stake with top painted red at approx. corner location.

ACCESSORIES : DESCRIBE NEW BT'S WITNESS OBJECTS ETC. ESTABLISHED, OR WORK DONE TO PRESERVE EXISTING EVIDENCE

Painted red ring around blaze and tied flagging in area.
Posted BT sign (54-3) and Attention sign (54-4).

Work Done By Mike Lilly Title ENGR AIDE Date 7/23/69 State Registration No. USFS
or Agency

Certified Cor. Record Prepared ? Yes No Filed At: _____ Date _____

Identified area on photo by ^{REMARKS} projecting from N.W. cor. of sec. 6, T 7S, R 35E.
The area had been logged since photos were taken and a pin prick
pt. could not be obtained.

Index File No. A-3 T. 7S R. 33E M. Will.

Tract or Surv. No.

Cor. A-3