


CERTIFIED RECORD OF LAND CORNER MONUMENTATION

History of original corner establishment:

Corner established in April, 1883, by Frank Campbell
under Contract No. 468.

Set stone 16" x 13" x 10" 8" in ground 5 notches on East
1 notch on West.

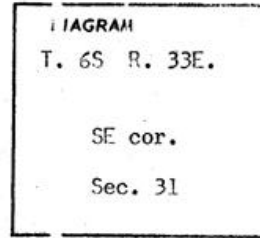

Pine 11 in. diam. brs. N 44° E 21 lks. marked T6S R33E S32 BT
Pine 30 in. diam. brs. S 52° E 39 lks. marked T7S R33E S5 BT
Pine 24 in. diam. brs. S 50° W 35 lks. marked T7S R33E S6 BT
Pine 30" diam. brs. N 14° W 50 lks. marked T6S R33E S31 BT

Description of corner evidence found:

Found stone in ground 7".

Pine 30 in. diam. brs. N 14° W 50 lks. (bearing N 12° W 36.9 ft.)
Pine 24 in. diam. brs. S 50° W 35 lks. (bearing S 58° W 22.5 ft.)

BT the N 44° E 21 lks. tree was down (bearing and distance check)
BT from S 52° E 39 lks. tree was down from the stump hole to rock distances
(Check)

Description of monument and accessories established to perpetuate the
original location of this corner

Set 2½" x 30" iron pipe 24" in ground with brass cap marked as shown
from which I scribed new bearing trees:


A fir 20 in. diam. brs. N 62° E 91.65 ft. marked S32 T6S R33E BT
A fir 12 in. diam. brs. S 15° E 24.60 ft. marked S5 T7S R33E BT

Mailed a brass washer marked PLS 933 to the BT blaze of both new trees. Set steel
post 3 ft. North of Corner. Used T-2 and steel tape, measuring a horizontal distance
to the center of the bearing trees.

REGISTERED
PROFESSIONAL
LAND SURVEYOR

David H. Krumbain

OREGON
JULY 17, 1870
DAVID H. KRUMBEIN
933

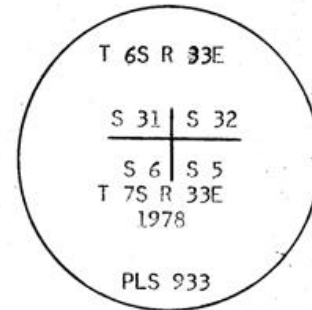

Office of..... County Surveyor..... County of Umatilla
State of Oregon....., I hereby certify that the within instrument was filed in this office
for record on the day of

..... by
(COUNTY OFFICIAL) (DEPUTY)

2-5

Q-911